


T. 36 S., R. 4 W., W.M.

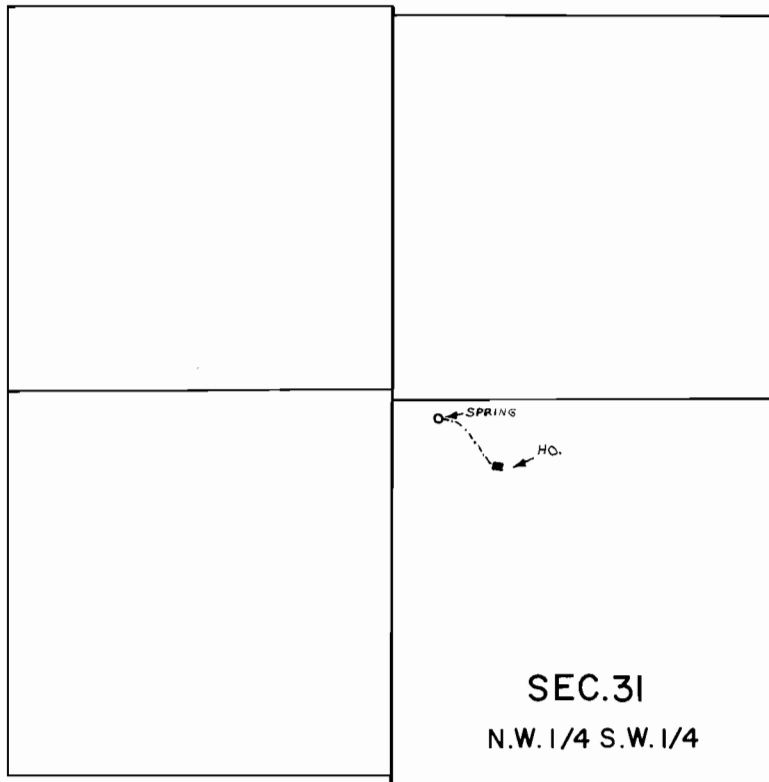

SPRING LOC: 60' S. & 160' E. FROM W. 1/4 COR. SEC. 31.

SCALE: 1" = 660'

FINAL PROOF SURVEY
UNDER

Application No. 53172 Permit No. 38794
IN NAME OF

T. E. &/OR BERNICE BUNTIN

Surveyed OCT. 10 1977, by B. SUND