


RECEIVED

JUL 13 1981

WATER RESOURCES DEPT
SALE, OREGON

T. 6S. R. 3W. W.M.

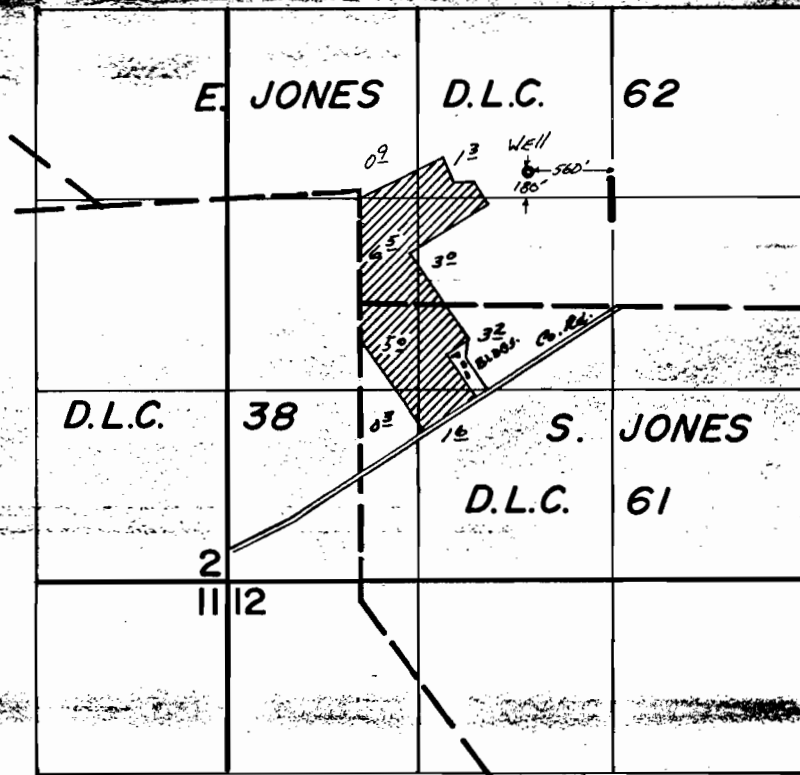

FINAL PROOF SURVEY
UNDER

Application No. G-7777 Permit No. G-7373
IN NAME OF

PHILLIP H. GOULET

Surveyed Oct. 12, 1978, by J.S. Donaldson