


T.15S. R.5W., W.M.

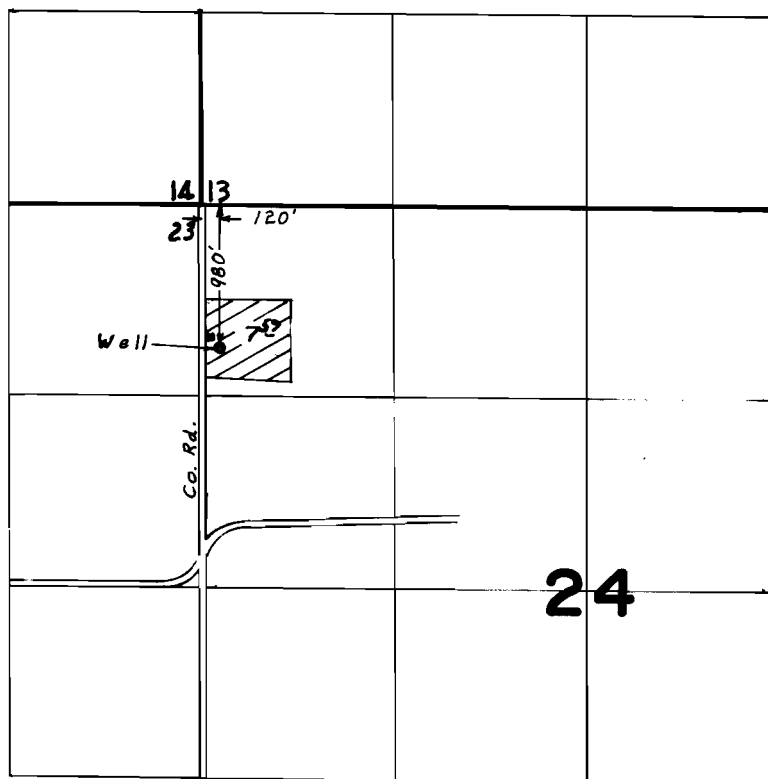

FINAL PROOF SURVEY
UNDER

Application No. G-7467 Permit No. G-7259
IN NAME OF

ELBERT & VELMA STARNES

Surveyed APR 26, 1978, by J.S. DONALDSON