


T.16S. R.4W., W.M.

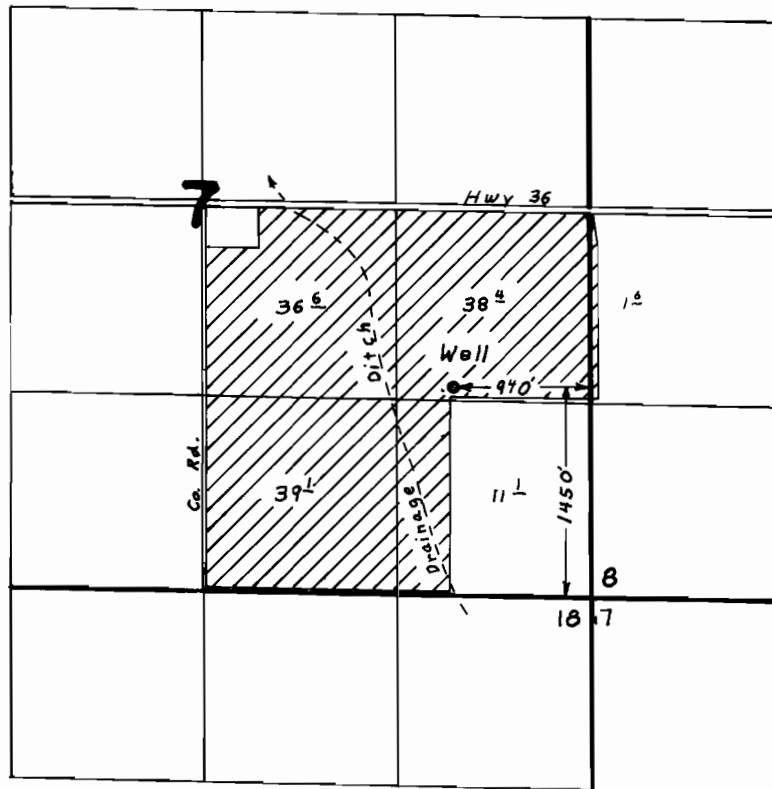

FINAL PROOF SURVEY
UNDER

Application No. G-7946 Permit No. G-7729
IN NAME OF

JAMES B. PITNEY

Surveyed APR. 26, 1978, by J. S. DONALDSON