


T.20S. R.5W., W.M.

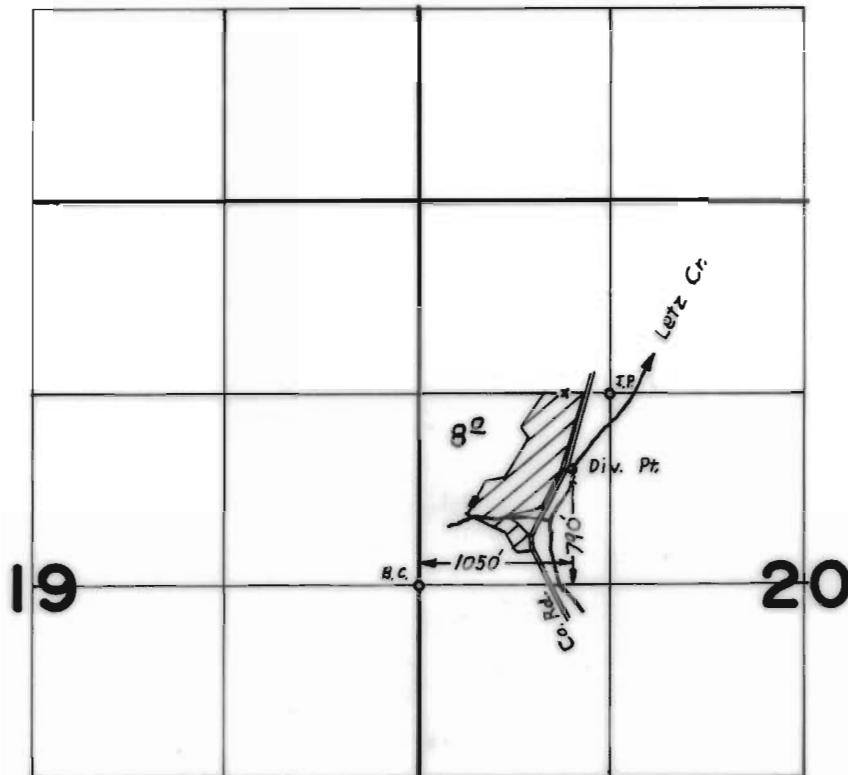

**FINAL PROOF SURVEY
UNDER**

Application No. 50880 Permit No. 38419
IN NAME OF

EVAN C. MANN

Surveyed MAR. 29 1978, by J. S. DONALDSON