


T.17S., R.9W., W.M.

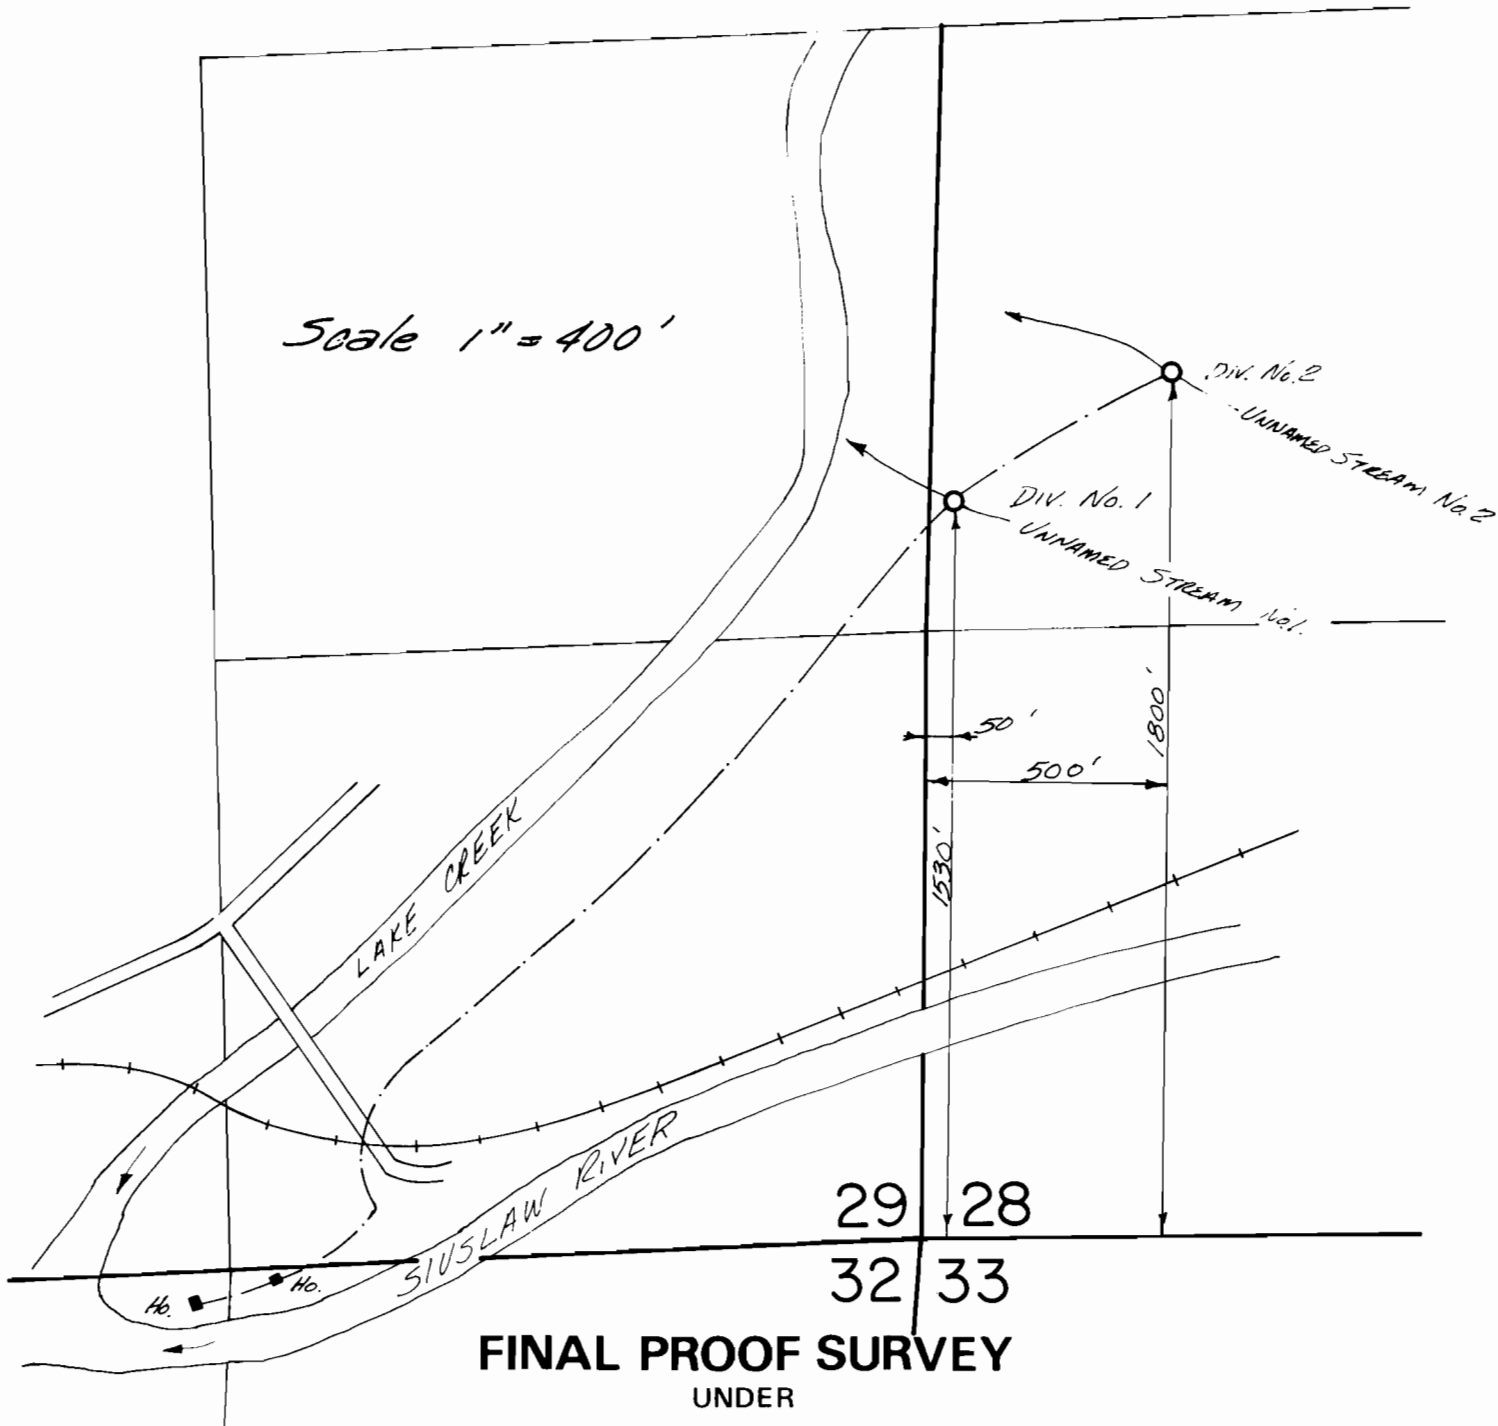

FINAL PROOF SURVEY UNDER

Application No. 52646 Permit No. 396???
IN NAME OF

John Seaver

Surveyed Aug 5, 1976, by L. E. GOULD
MAY 25, 1979 R. G. MUCKEN