


T.6S.R.2W., W.M.

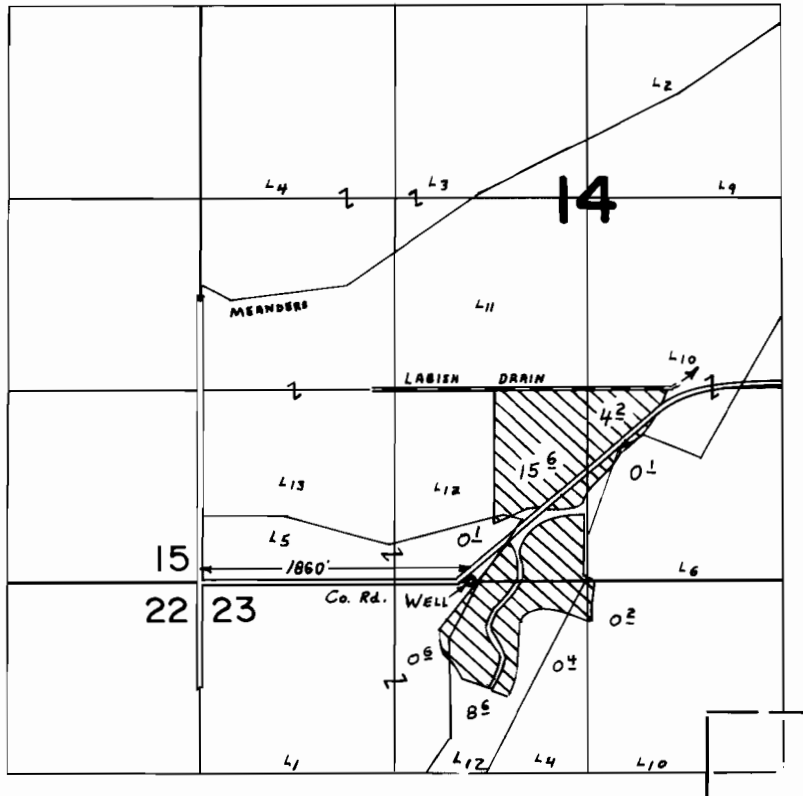

FINAL PROOF SURVEY UNDER

Application No. G-6640. Permit No. G-6206.....
IN NAME OF

.....DON METHENY.....

Surveyed APR. 26. 1979., by L.H. NUNN.....