


T. 6S.R. 2W.W.M.

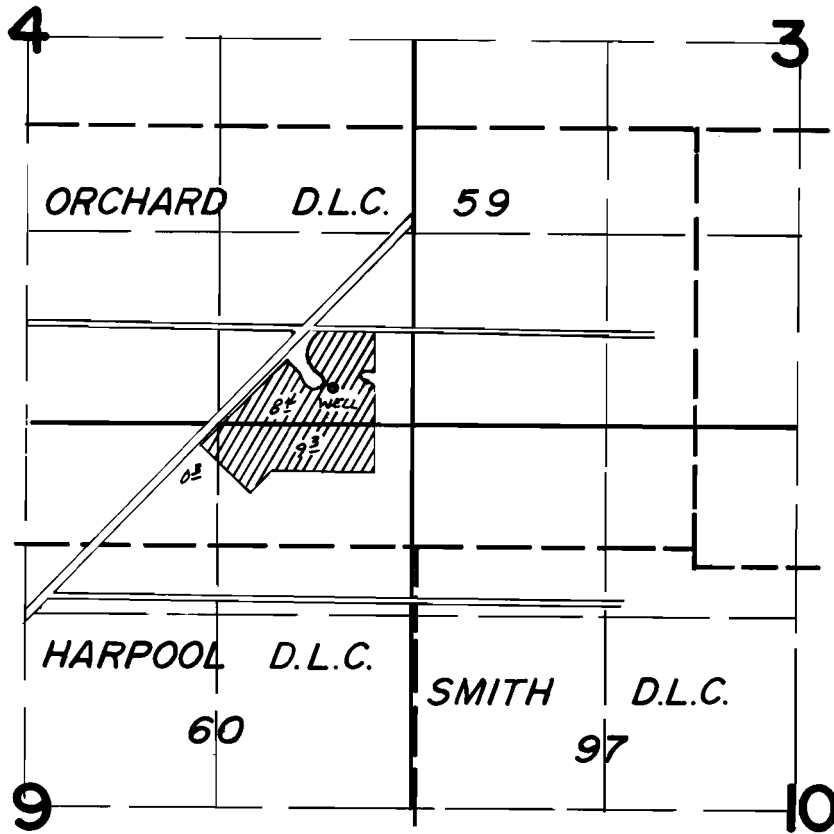

WELL LOC. - 250' N & 550' W FROM S.E. COR. SEC. 4

FINAL PROOF SURVEY UNDER

Application No. G-7617... Permit No. G-7063.
IN NAME OF

PETE SPROED

Surveyed Oct. 11, 1978, by J.S. Donaldson...