


T.6S. R.2W., W.M.

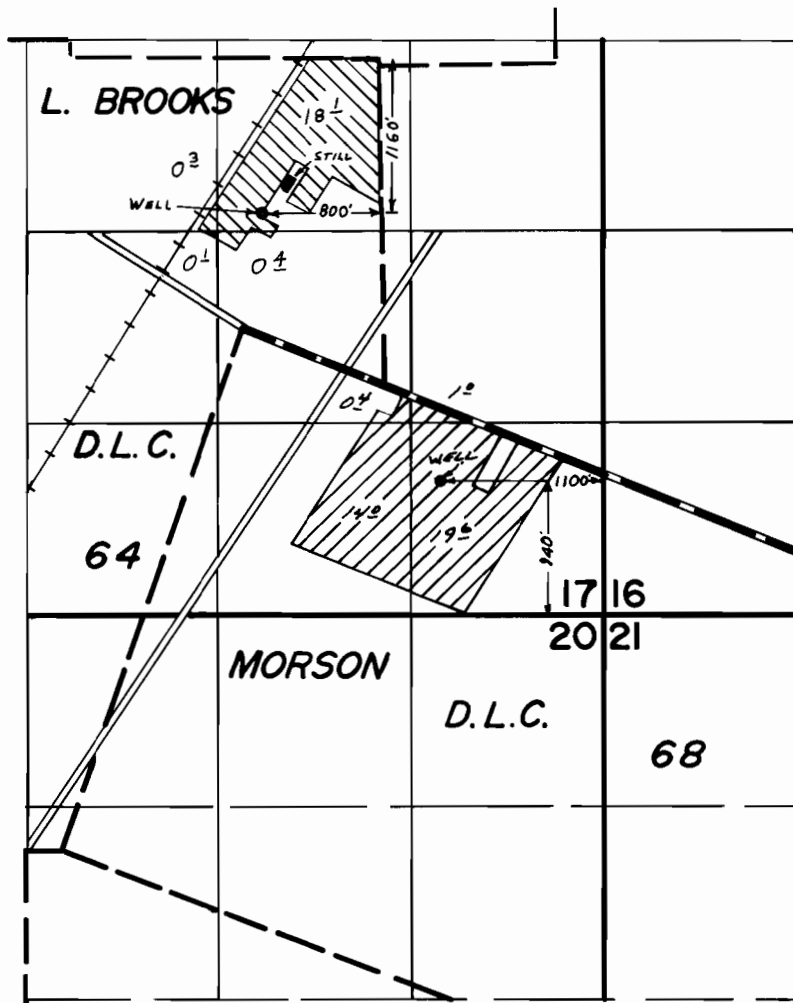

FINAL PROOF SURVEY UNDER

G-8046 G-7544
 Application No. G-8045. Permit No. G-7.4.56
 IN NAME OF



..... PHILIP W. BEILKE

Surveyed Oct. 9, 1978, by J.S. Donaldson.
 APR 25 1979 L. H. NUNN