


# T.6S. R.2W, W.M.

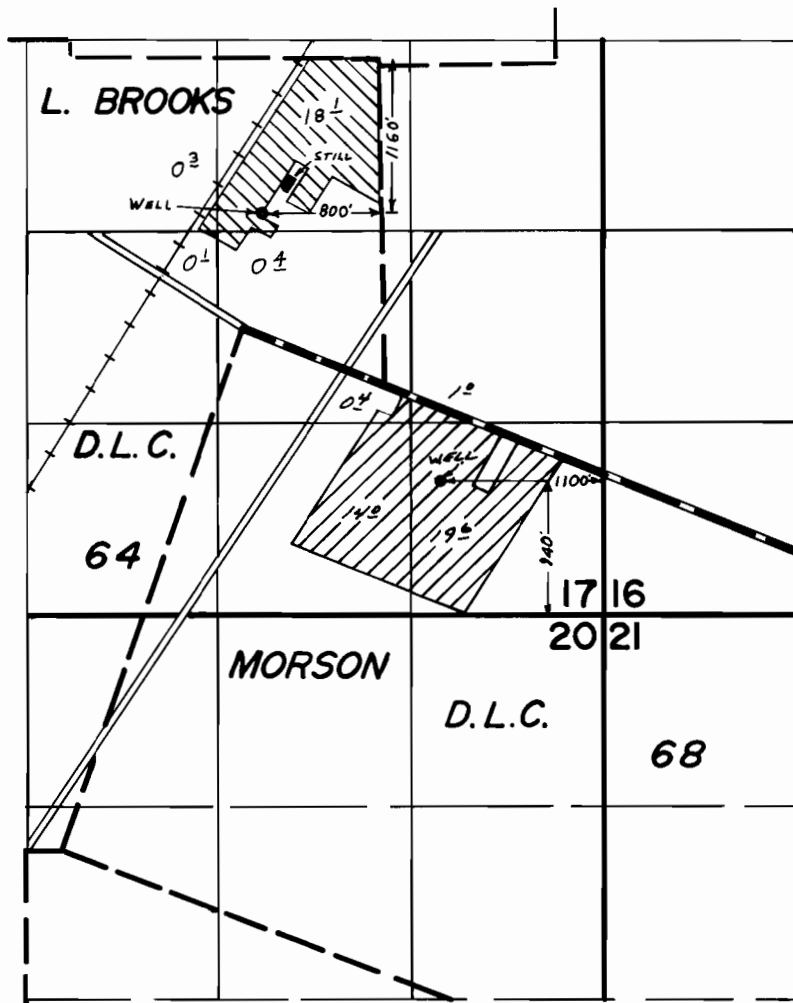

## FINAL PROOF SURVEY UNDER

G-8046                      G-7544  
 Application No. G-8045. Permit No. G-7.4.56  
 IN NAME OF



..... PHILIP W. BEILKE .....

Surveyed Oct. 9, 1978, by J.S. Donaldson.  
 APR 25 1979                      L. H. NUNN