


T.5S. R.1W., W.M.

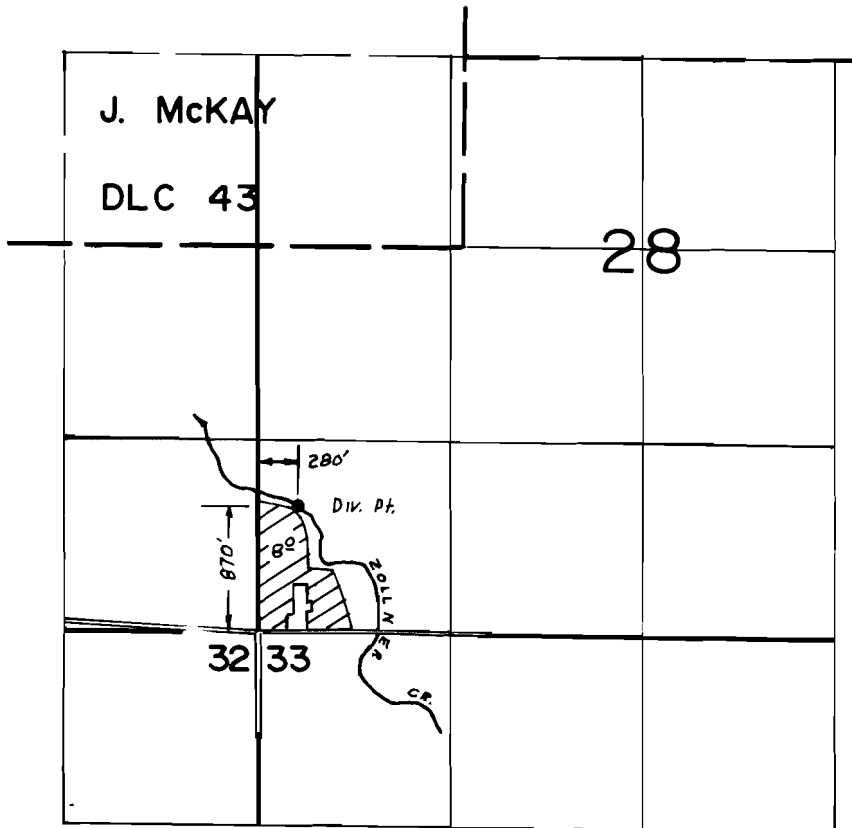

FINAL PROOF SURVEY UNDER

Application No. 54718..... Permit No. 41050.....
IN NAME OF

Melvin R. & Marilyn D. Byrads

Surveyed SEPT. 9. 1977, by B.R. SUND.....