


**RECEIVED**

SEP 8 1976

LAND RESOURCES DEPT.  
OREGON

T.8S. R.3W.W.M.

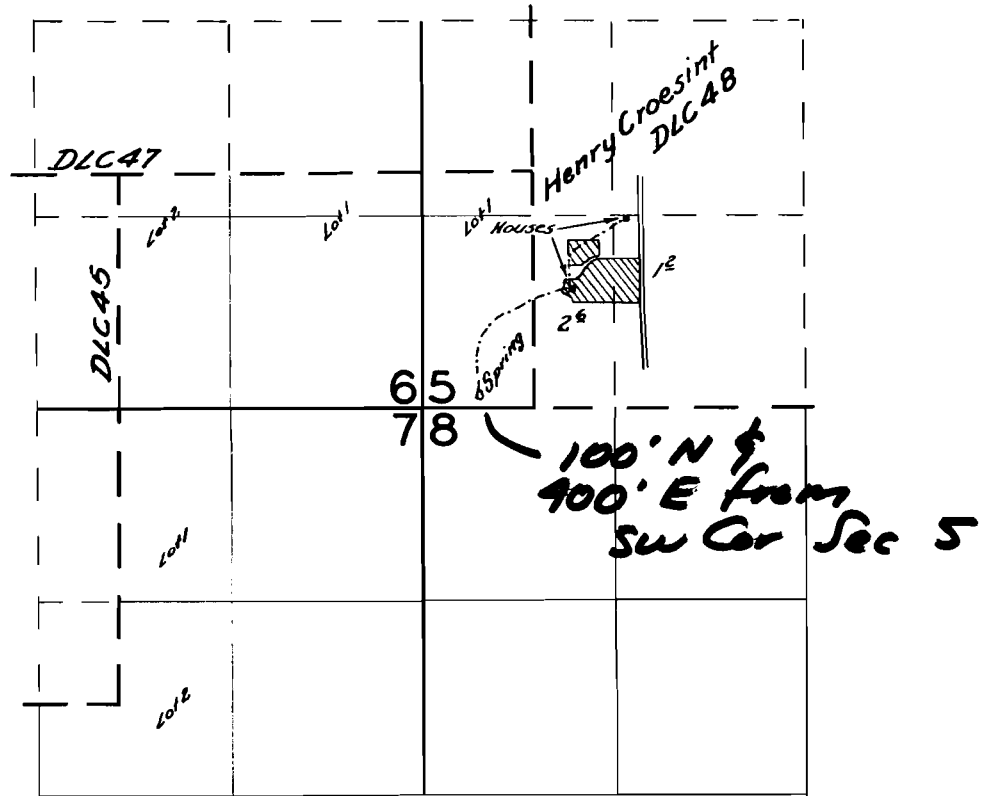

Application No. 54757  
Permit No. 41074

**FINAL PROOF SURVEY**  
UNDER

Application No. 20393 Permit No. 16064  
IN NAME OF

*Lee Byers*

Surveyed June 4, 1956, by *R.H. Whitby*