


T. 6S., R. 6W., W.M.

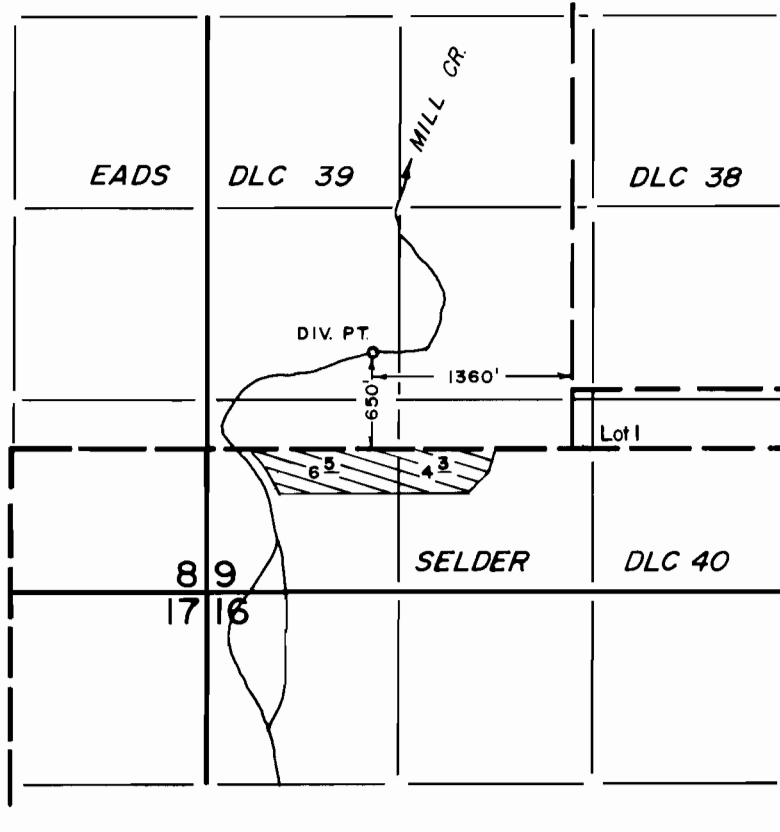

**FINAL PROOF SURVEY**  
UNDER

Application No. 55175... Permit No. 41350.....  
IN NAME OF

.....**HUGH VEACH**.....

Surveyed **JUNE 1**..... 19**79**, by **R.G.MUCKEN**.....