T1S. R13E. WM.

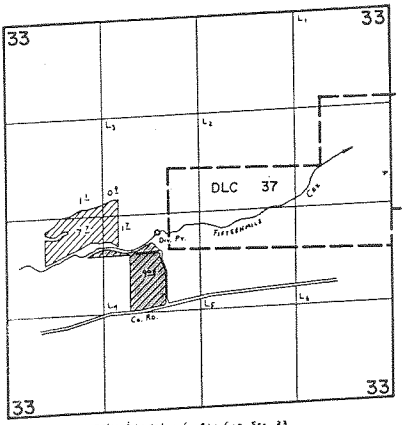

DIV. PT. LOC: 2470'N. & 2050'W. fr. S.W. COR. SEC. 33.

FINAL PROOF SURVEY

UNDER

Application No. ~~49338~~ 49337. Permit No. ~~36988~~ 36987

IN NAME OF

HARRIET & WILFORD MOE

Surveyed June 27, 1979, by C. L. HUGHES

41065-872-241