


T. 7 S. R. 39 & 40 E. W. M.

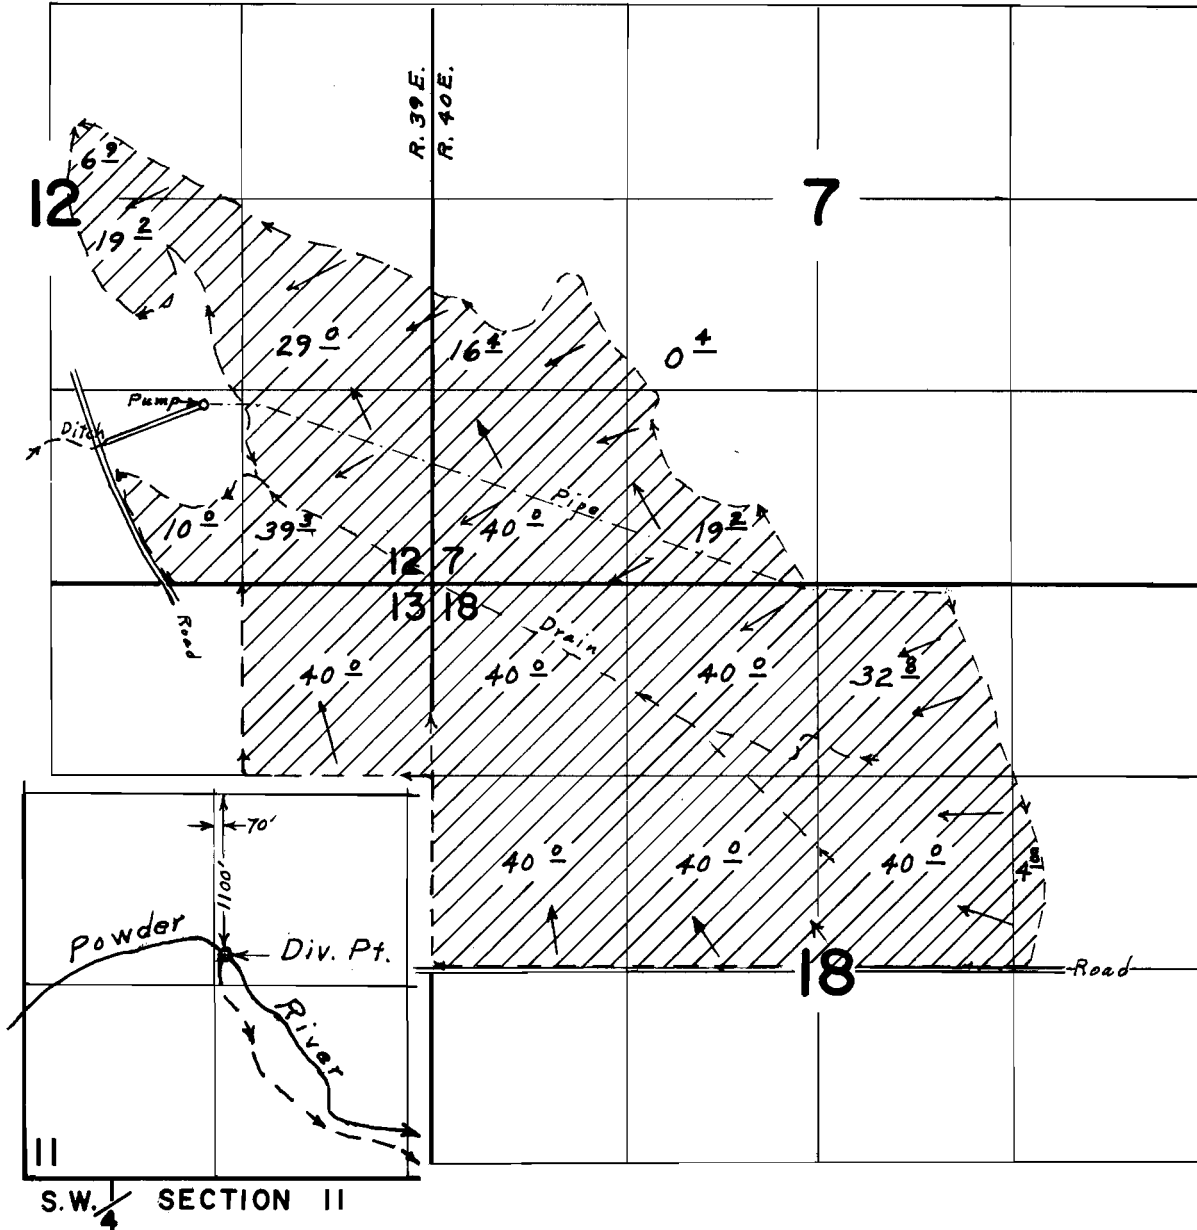

FINAL PROOF SURVEY

UNDER

Application No. 41884 Permit No. 31337

IN NAME OF

WALTER JACOBSON

Surveyed May 14, 1970, by L. E. Gould