


**T. 11 S. R. 6 W. W. M.**

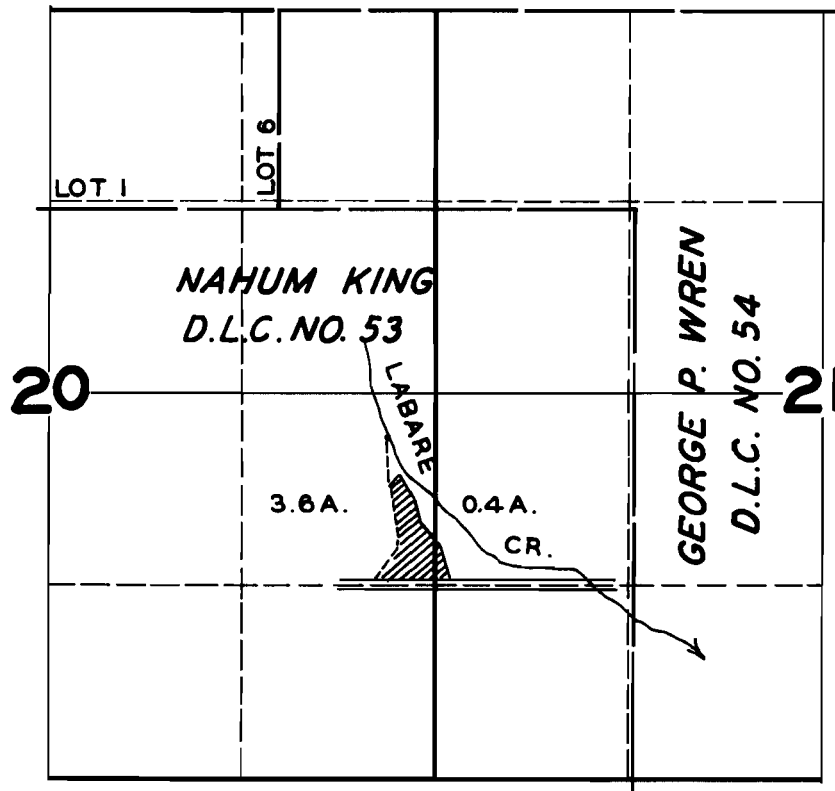

**FINAL PROOF SURVEY**  
UNDER

Application No. **19379** ... Permit No. **14995**  
IN NAME OF

**WILLIAM MULLER**

Surveyed **JULY 5, 1948**, by **JAS. E. BUNNELL**