


T. 10S. R. 6W. W.M.

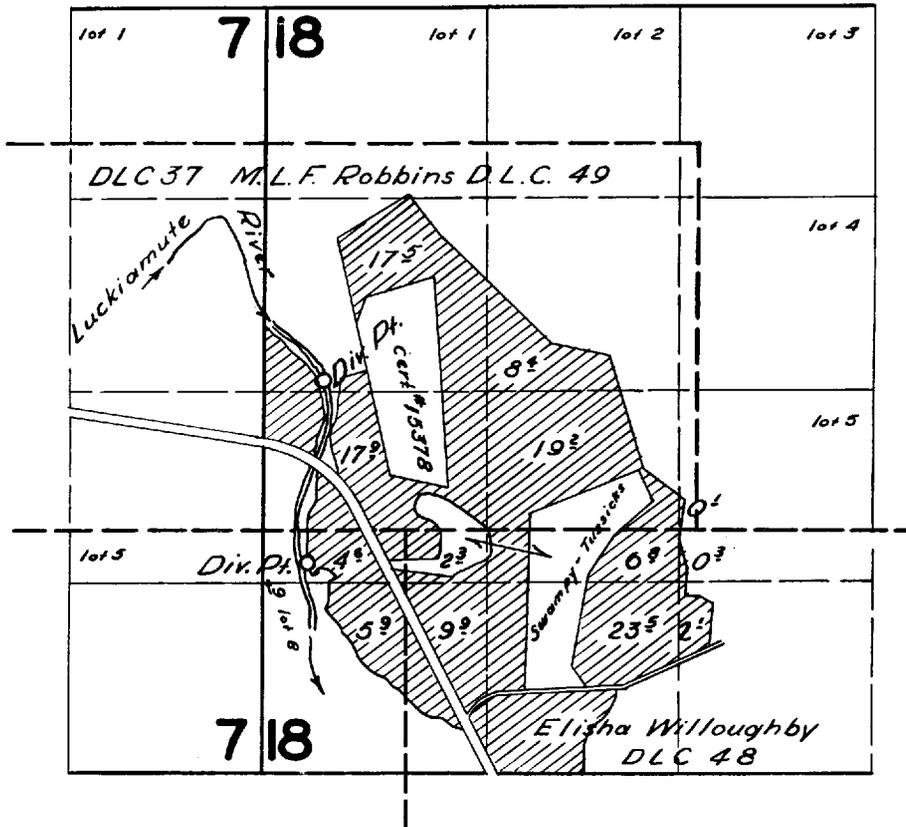

FINAL PROOF SURVEY
UNDER

Application No. 26558 Permit No. 20809
IN NAME OF

REX & ETHEL CLEMENS

Surveyed 4 Sept. 1957, by *[Signature]*