


T.13S. R.15E. WM.

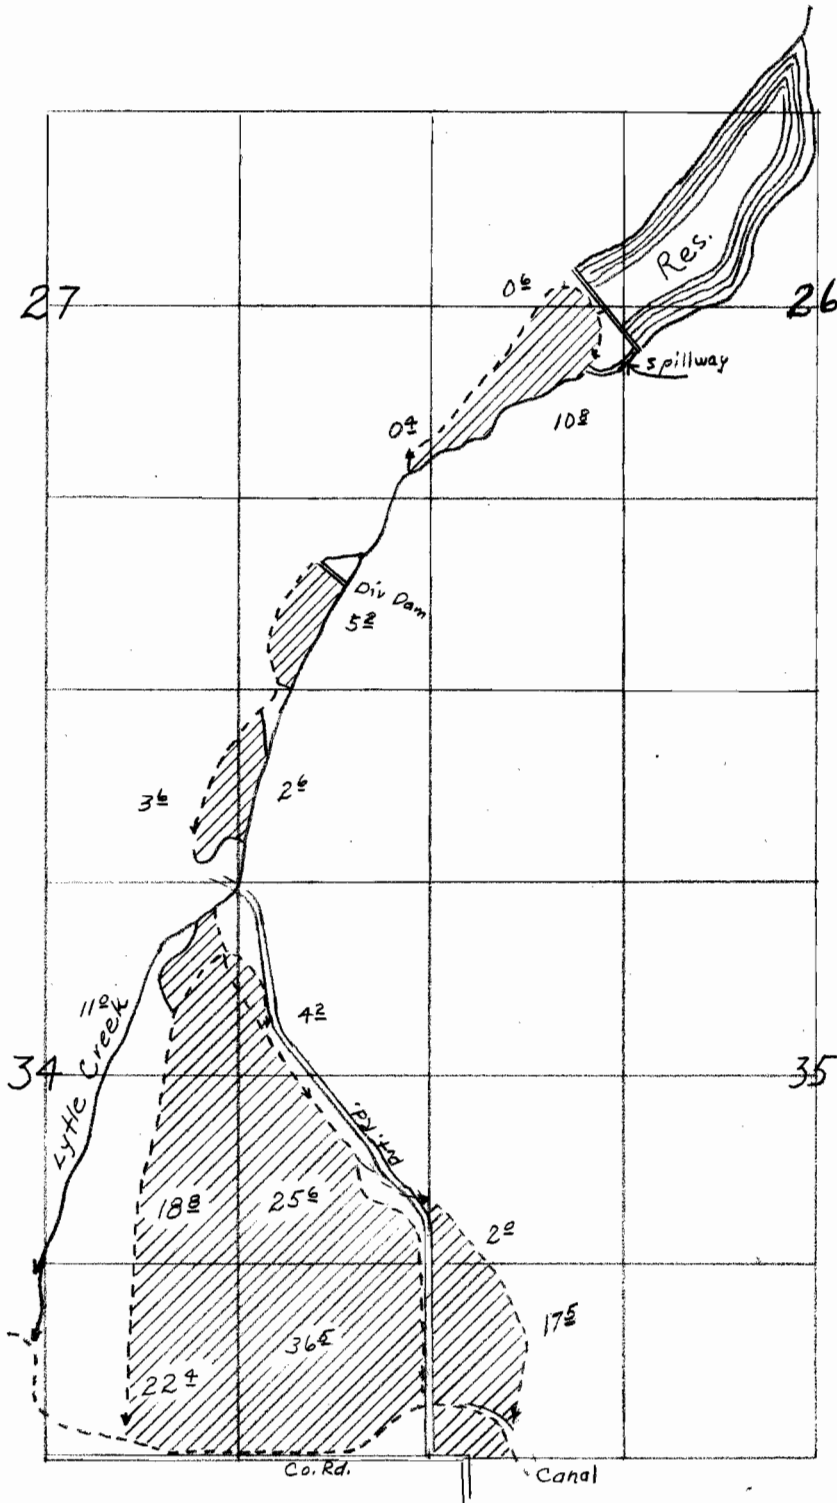

FINAL PROOF SURVEY

UNDER

Application No. ²³⁵²¹ ~~27901~~ ²²⁷²⁰⁰ ~~223520~~ Permit No. ¹⁸⁶³⁶ ~~21977~~ ^{R-1468} ~~R-966~~

IN NAME OF

J.O. Fisher

Surveyed Apr 26 1955, by T. Jones