


T. 29 S. R. 4 W. W. M.

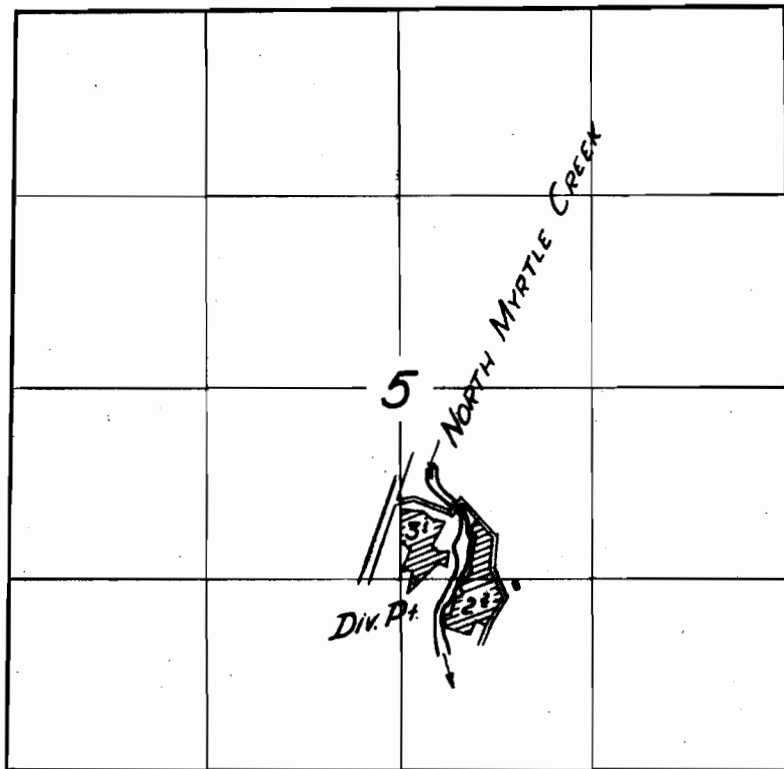

FINAL PROOF SURVEY
UNDER


Application No. 29037 Permit No. 22843

IN NAME OF

STANLEY F. MOHR

Surveyed 26 Sept 1956, by *Edw. J. Kelly*

T. 29 S. R. 4 W. W. M.

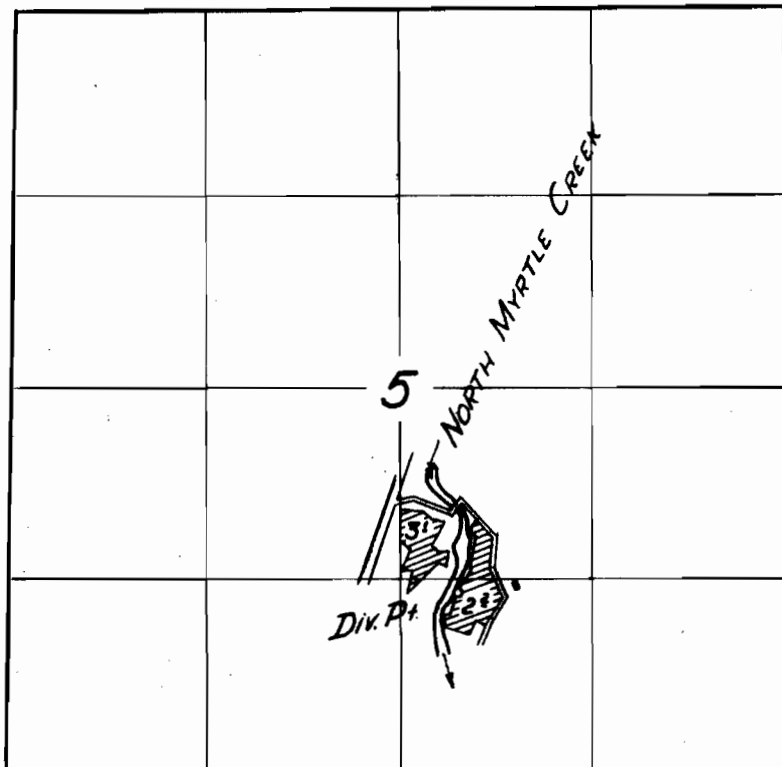

FINAL PROOF SURVEY
UNDER

Application No. 29037 Permit No. 22843

IN NAME OF

STANLEY F. MOHR

Surveyed 26 Sept 1956, by *Edna ...*