


T.30S.R.5W.W.M.

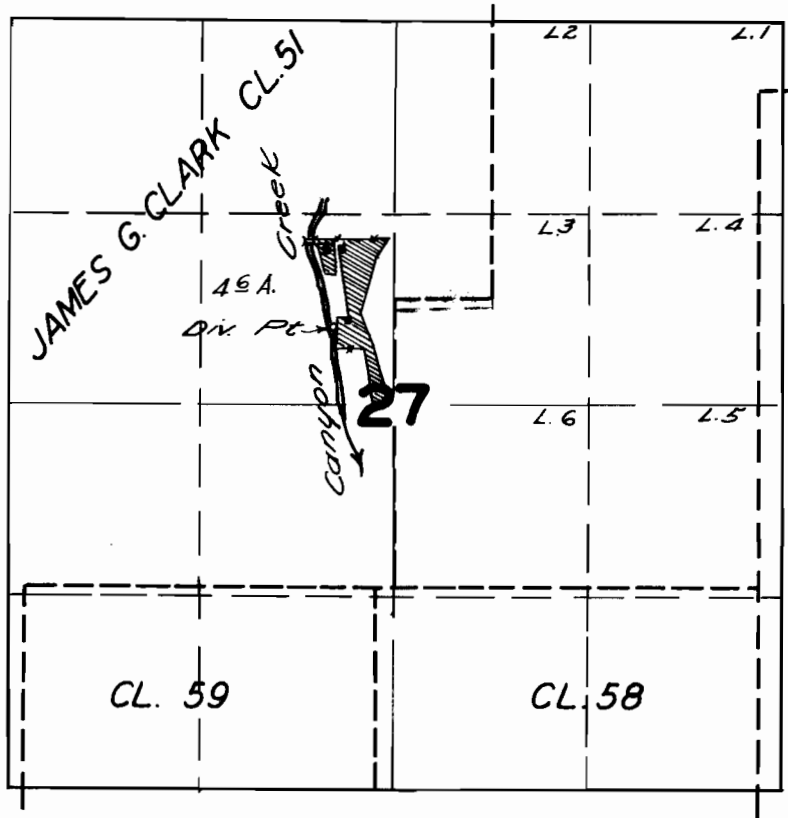

FINAL PROOF SURVEY

UNDER

Application No. **22168**.. Permit No. **17456**..
IN NAME OF

JOHN. HAMLIN

Surveyed **MAY 23 1950.**, by **H.L. COFFMAN**..