


T-4748

T. 32 S. R. 4 W. W.M.

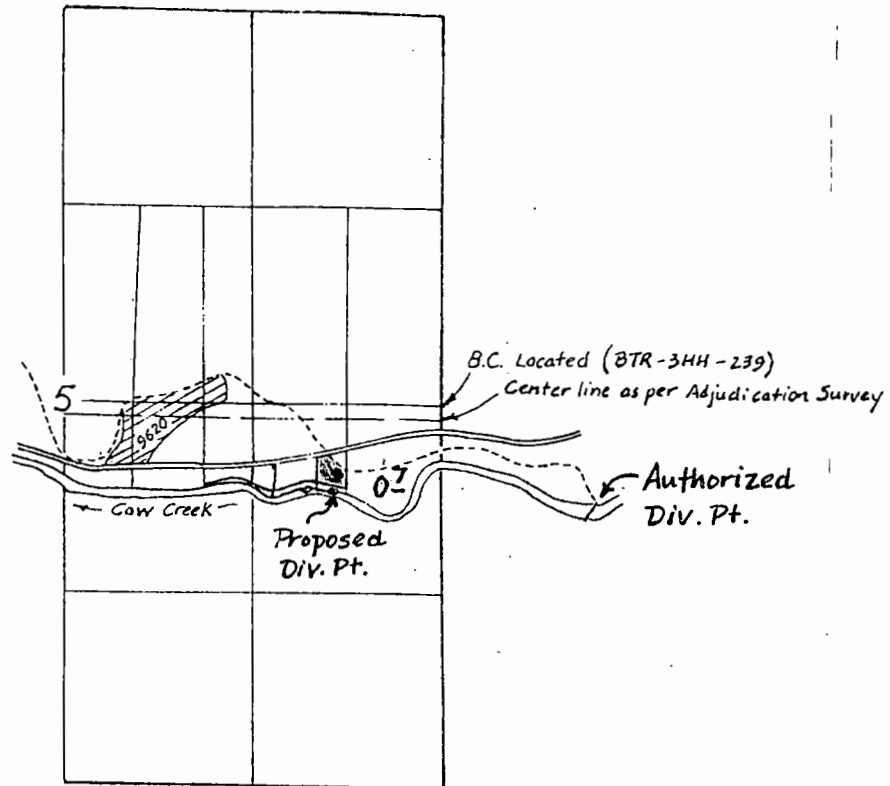

Scale: 4" = 1 mile
Cert. 9613

Proposed Div. Pt.: 600' S. and 740' W. }
Authorized Div. Pt.: 650' S. and 1050' E. } from E $\frac{1}{4}$ Cor. Sec. 5