


G-3497

50133
39963

T.11S. R.29E. W.M.

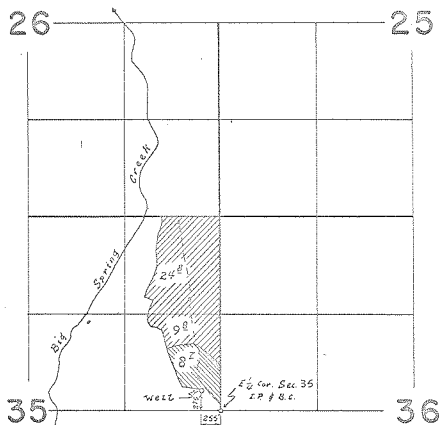

Primary 
 Supplemental 

FINAL PROOF SURVEY UNDER

Application No. G-3694 Permit No. G-3497
 IN NAME OF

Nicolas Bonifacich

Surveyed 2 Aug. 1972, by L.E. Gould