


T23S. R.31E. W.M.

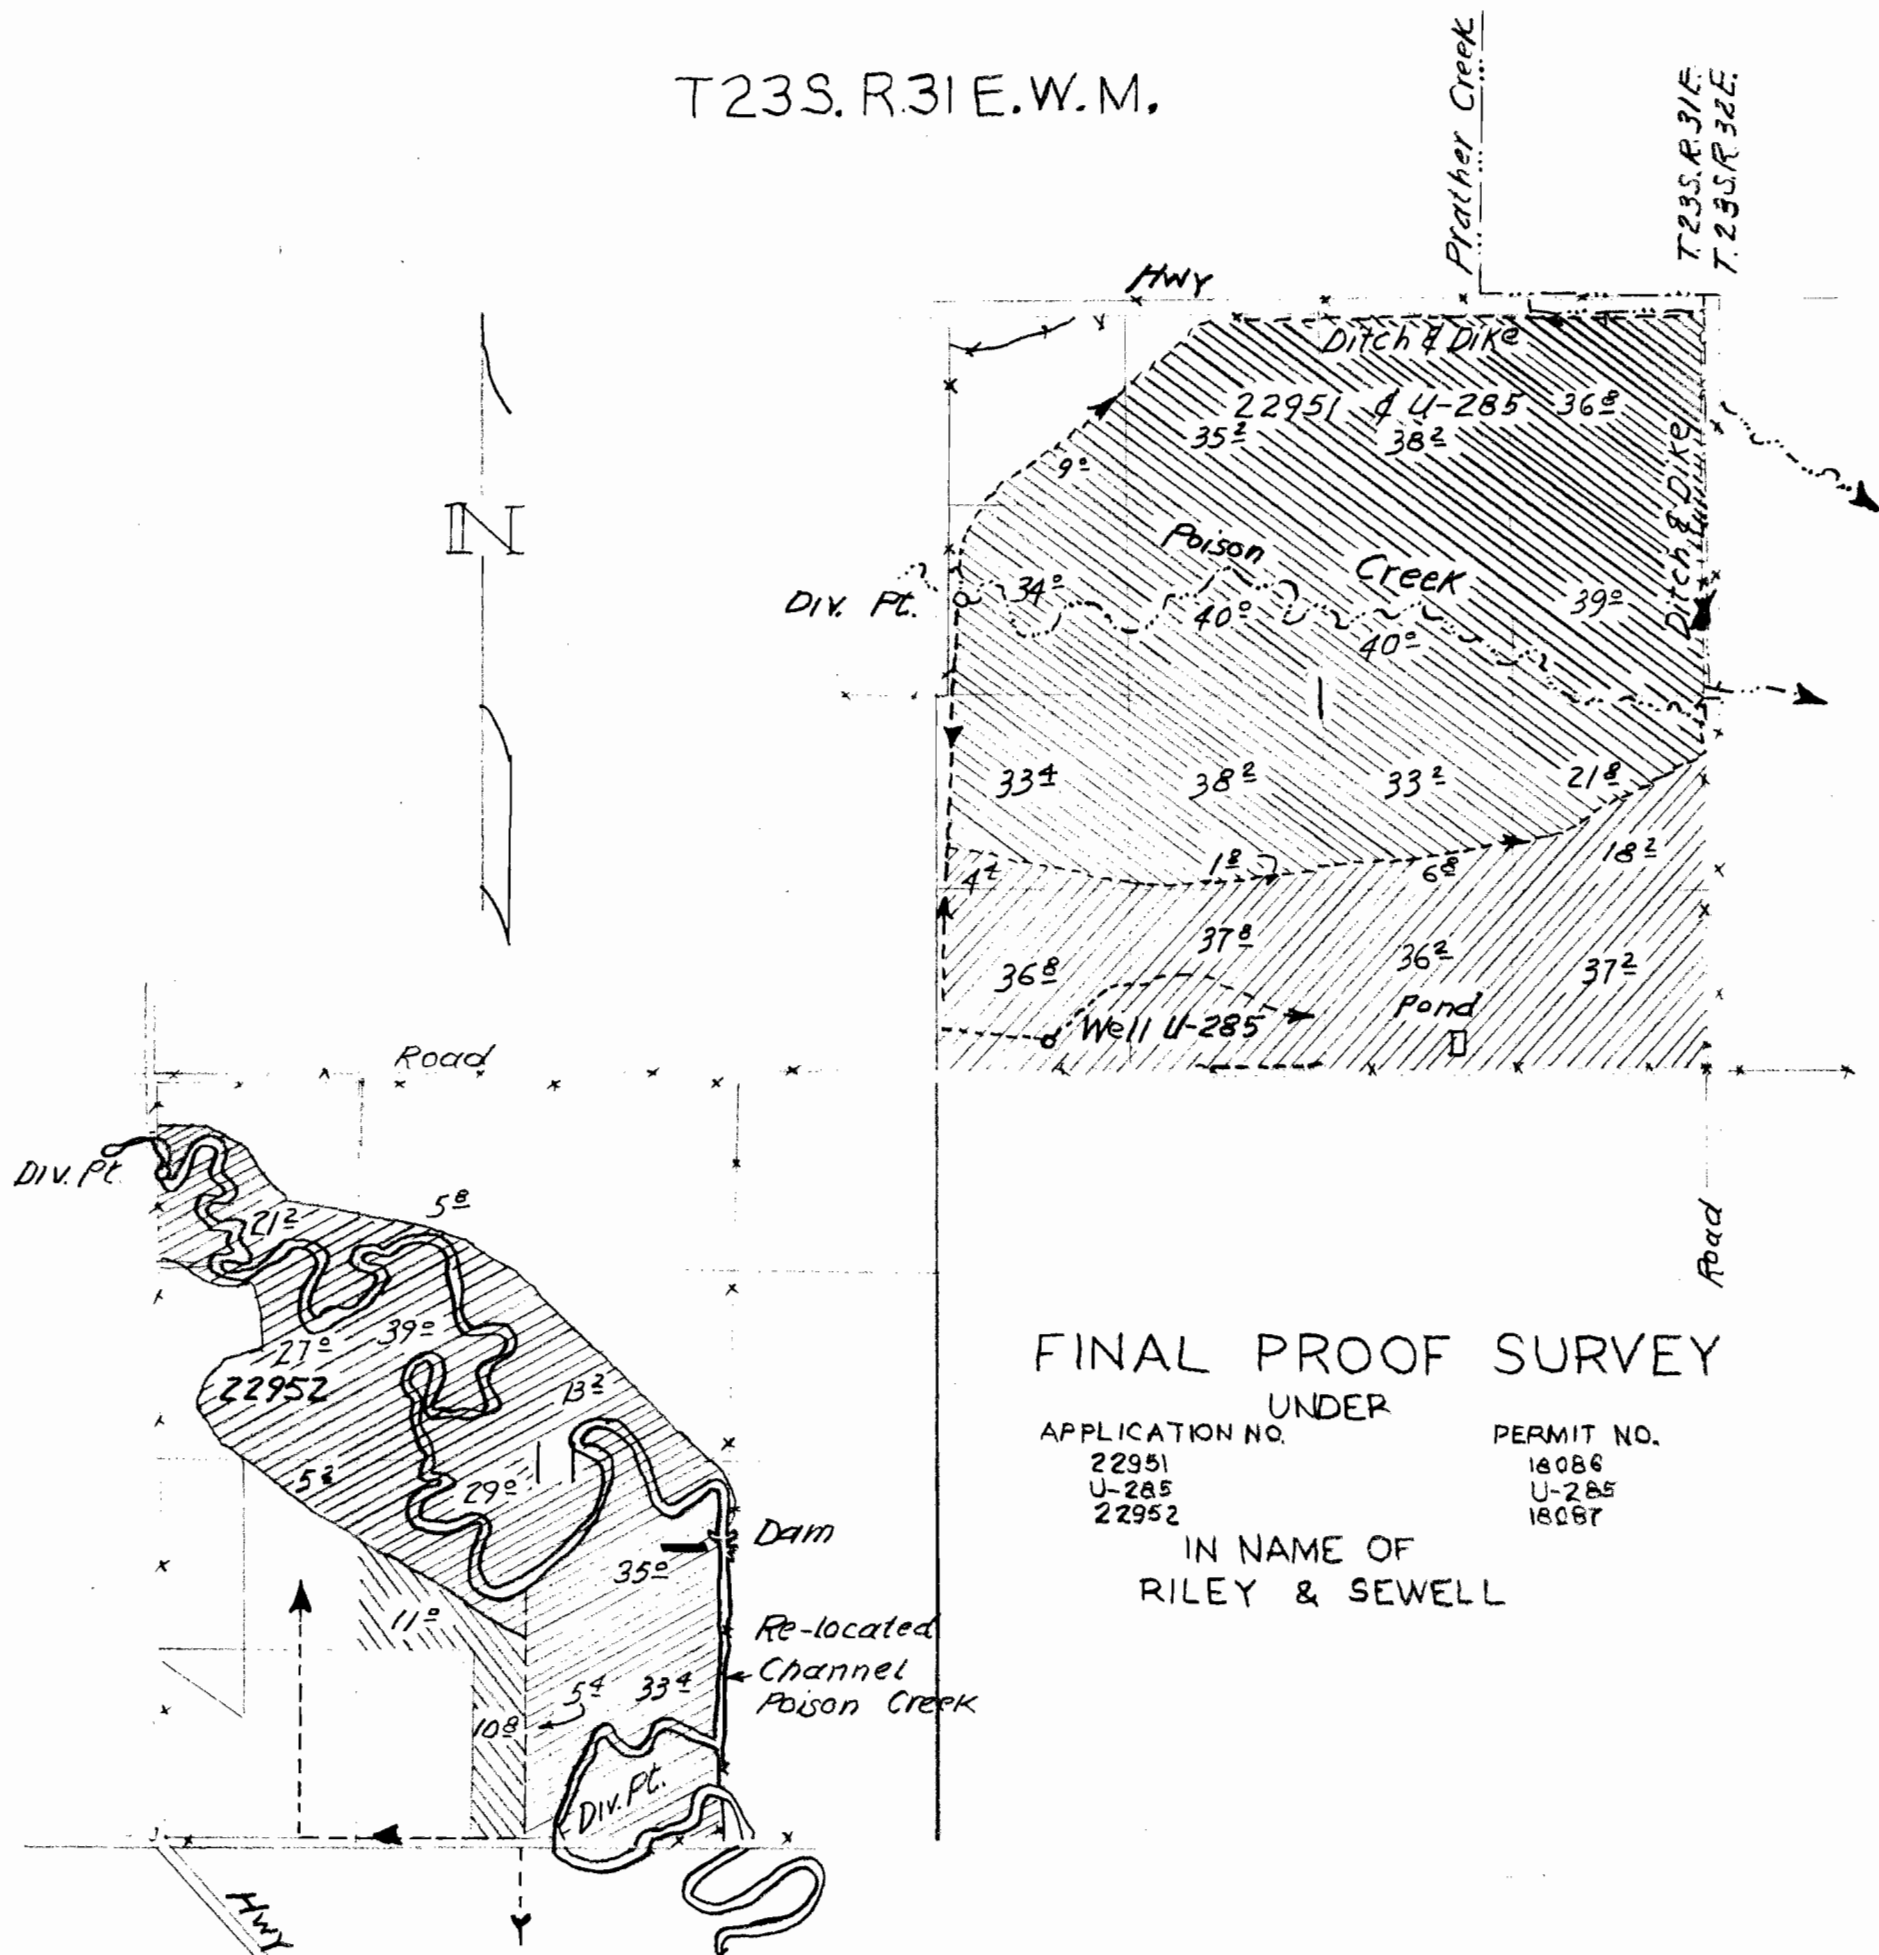

FINAL PROOF SURVEY

UNDER

APPLICATION NO.

22951
U-285
22952

PERMIT NO.

18086
U-285
18087

IN NAME OF
RILEY & SEWELL

copy of original final proof survey map