


T. 38 S. R. 3 W. W. M.

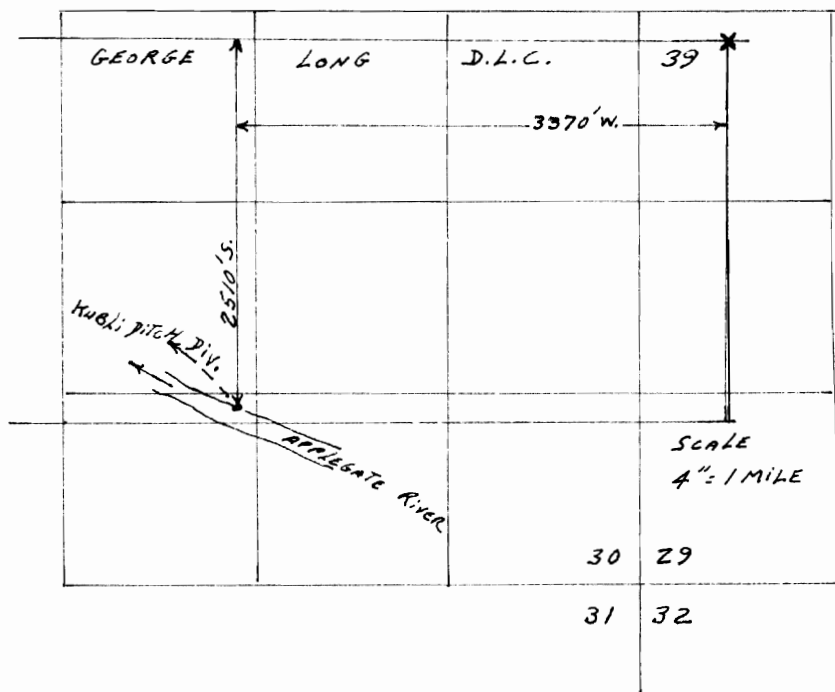

MAP TO ACCOMPANY APPLICATION
OF BARBARA L. GRANT %
GENE KIMBALL FOR CHANGE IN
POINT OF DIVERSION

CERT. #
46562

CERT. #
46563

T. 38 S R. 4 W. W. M.

