
T.36S.,R.4W.,W.M

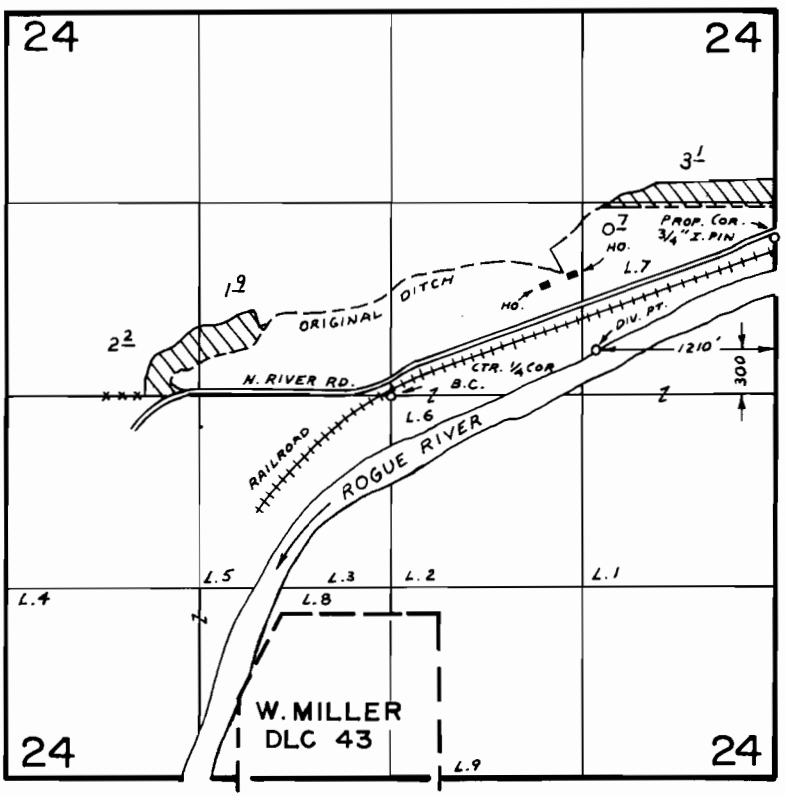

FINAL PROOF SURVEY
UNDER

TRANSFER NO. 3148

Application No. ..... Permit No. .....

IN NAME OF

ROBERT D. MURPHY

Surveyed JUNE 18 1980., by B. SUND

PHOTO: 850-10-6