


T. 33 S., R. 6 W., W.M.

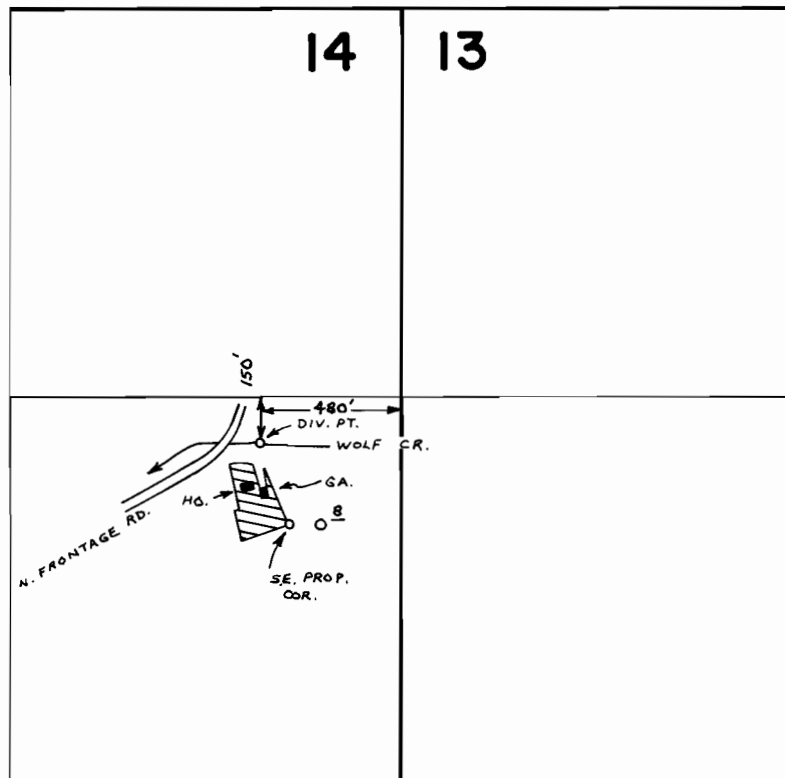

SCALE : 1" = 660 FT.

FINAL PROOF SURVEY
UNDER

Application No. **49275** Permit No. **36929**
IN NAME OF

EARNEST PECK

Surveyed **NOV. 4** 19**77**, by **B. SUND**