


# T.I.S. R.I.E.W.M.

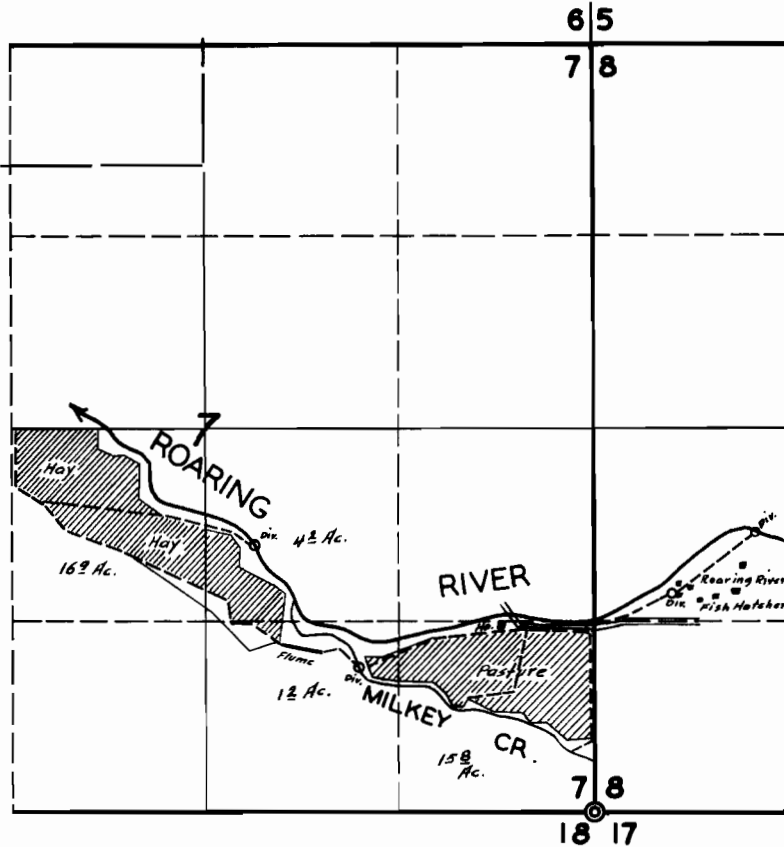

## FINAL PROOF SURVEY UNDER

Application No. 17749 Permit No. 13506

IN NAME OF

C.E. STEYAERT

Surveyed JUNE 21 1945, by