


T.7S.R.1W.W.M.

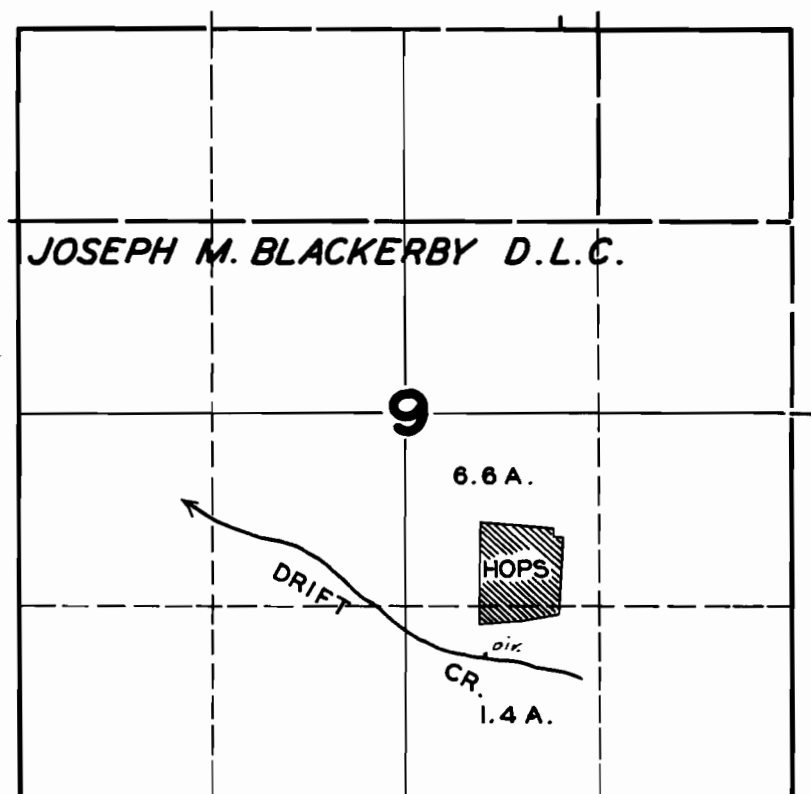

JOSEPH M. BLACKERBY D.L.C.

9

6.6 A.

HOPS

CR.

1.4 A.

**FINAL PROOF SURVEY
UNDER**

Application No. 20282 Permit No. 15822

IN NAME OF

MONROE HANSON

Surveyed OCT. 25 1947, by JAS. E. BUNNELL