


T. 3 N. R. 26 E. W.M.

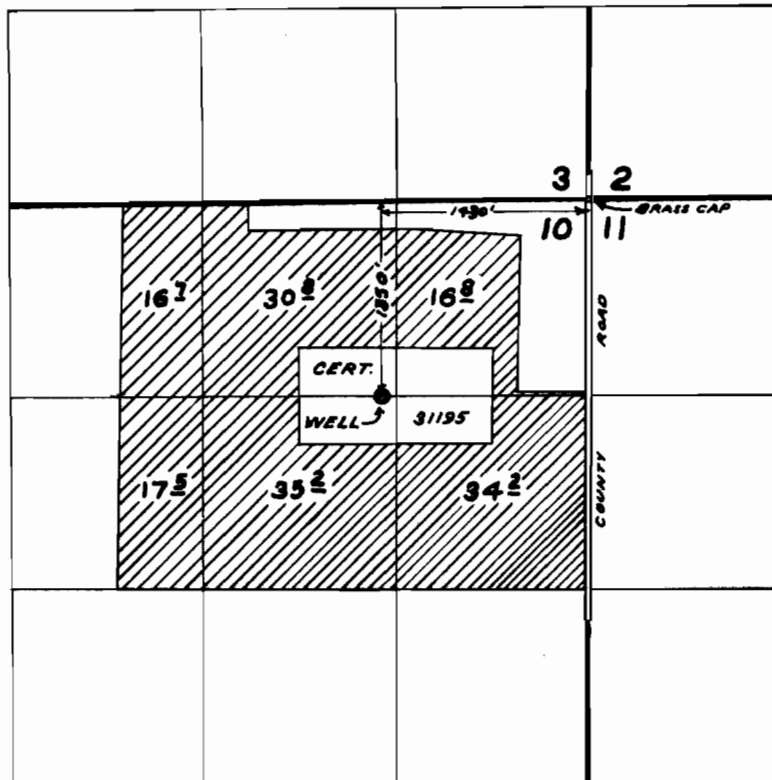

FINAL PROOF SURVEY UNDER

Application No. G-1224 Permit No. G-1070
IN NAME OF
WALDO H. CRAMER

Surveyed AUG. 3 1966, by L. GOULD