


T. 1S. R. 48E. W.M.

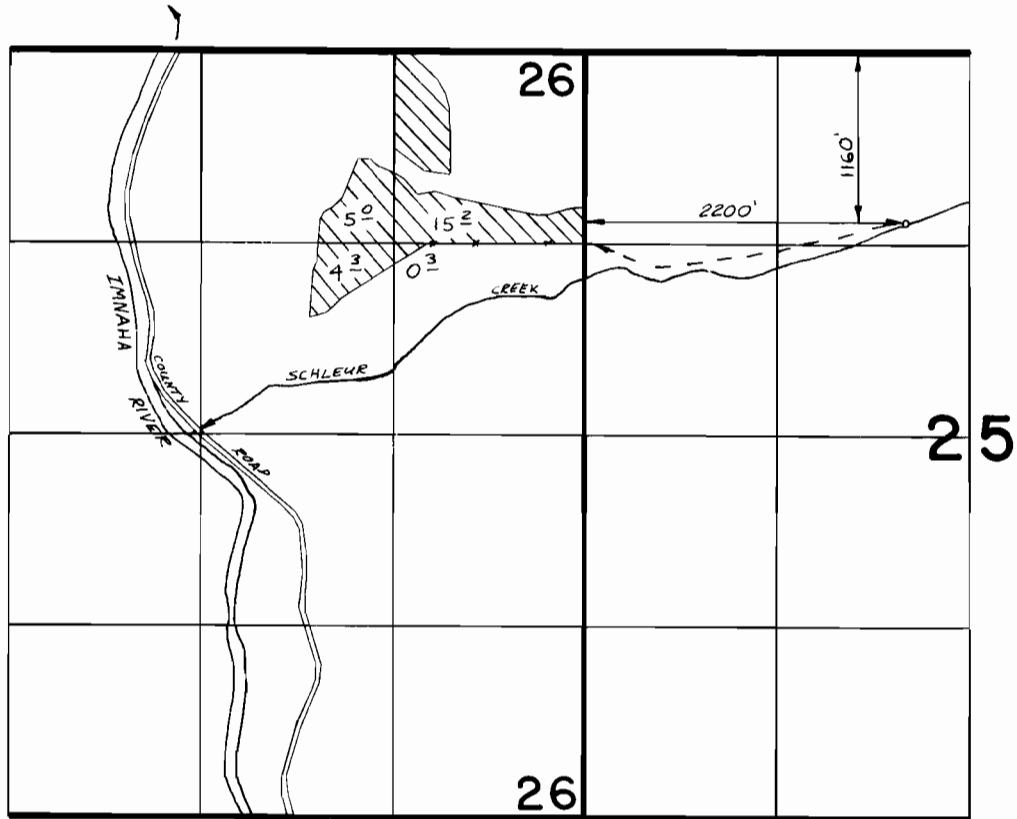

FINAL PROOF SURVEY
UNDER

TRANSFER 2637

Application No. Permit No.

IN NAME OF

IMNAHA SPRINKLER ASSN.

Surveyed 8-24 1978, by R. BARWIN