


T. 35S., R. 2W., W.M.

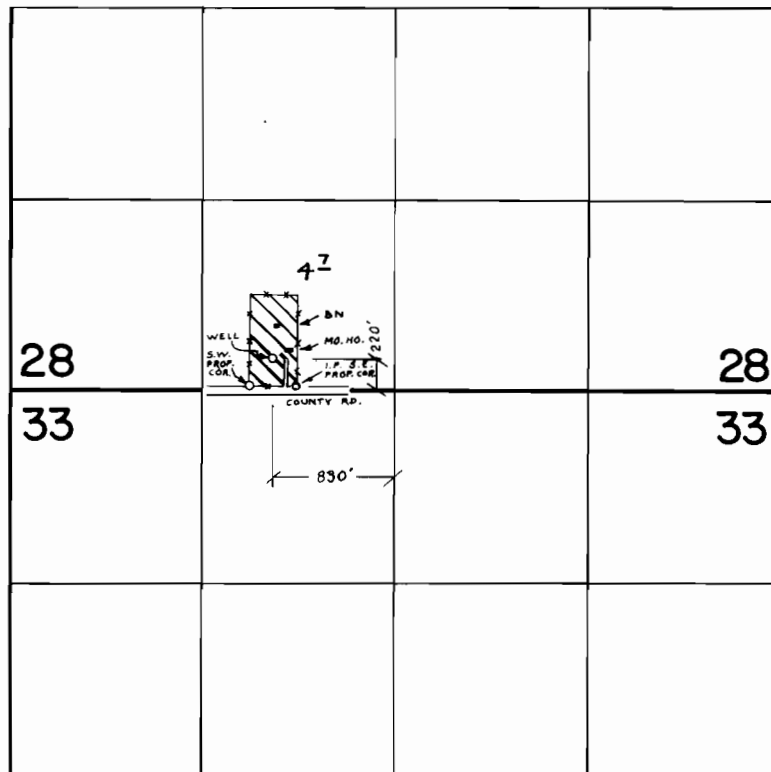

FINAL PROOF SURVEY
UNDER

Application No. G-6503 Permit No. G-6118
IN NAME OF

MELVIN & SARA KIGHT

Surveyed APR. 12 1978 by B. SUND