


T.34S., R.4W., W.M.

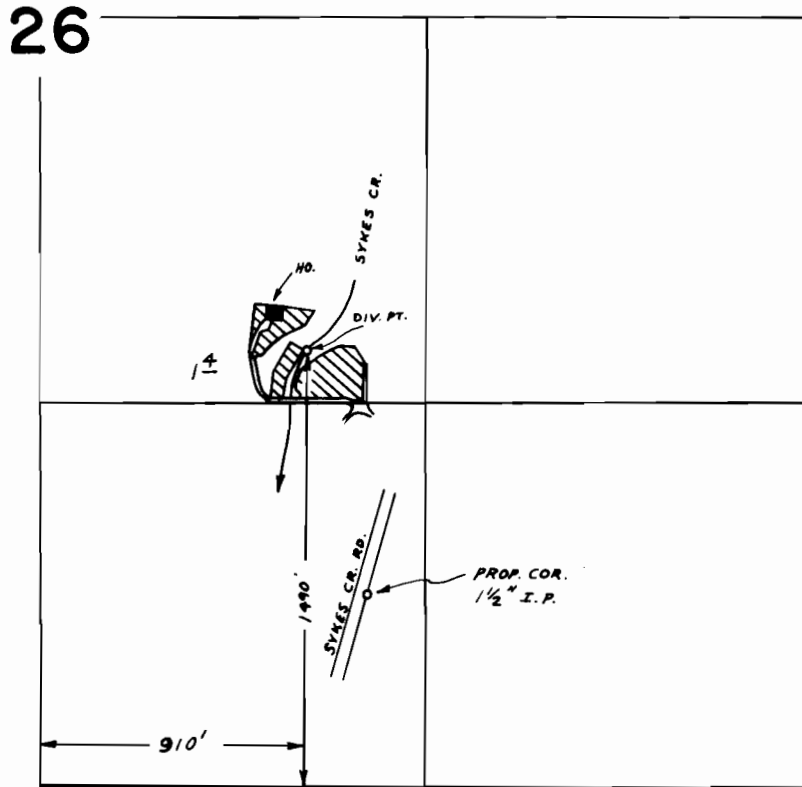

SCALE : 1" = 660 FT.

FINAL PROOF SURVEY UNDER

Application No. 47235 Permit No. 35382
IN NAME OF

LESLIE M. & EVA W. CHRISTENSEN

Surveyed NOV. 14 1978, by B. SUND