


T. 35 S., R. 4 W., W.M.

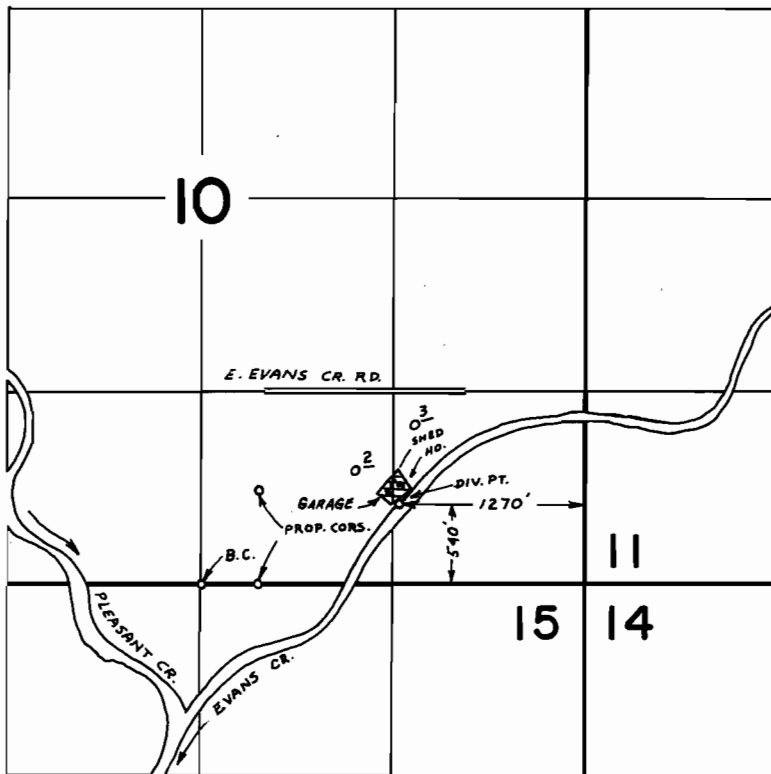

FINAL PROOF SURVEY
UNDER

Application No. 48075 Permit No. 36060
IN NAME OF

LAWRENCE PESTERFIELD

Surveyed MAY 16 1978, by B. SUND