


T. 35 S., R. 3 W., W.M.

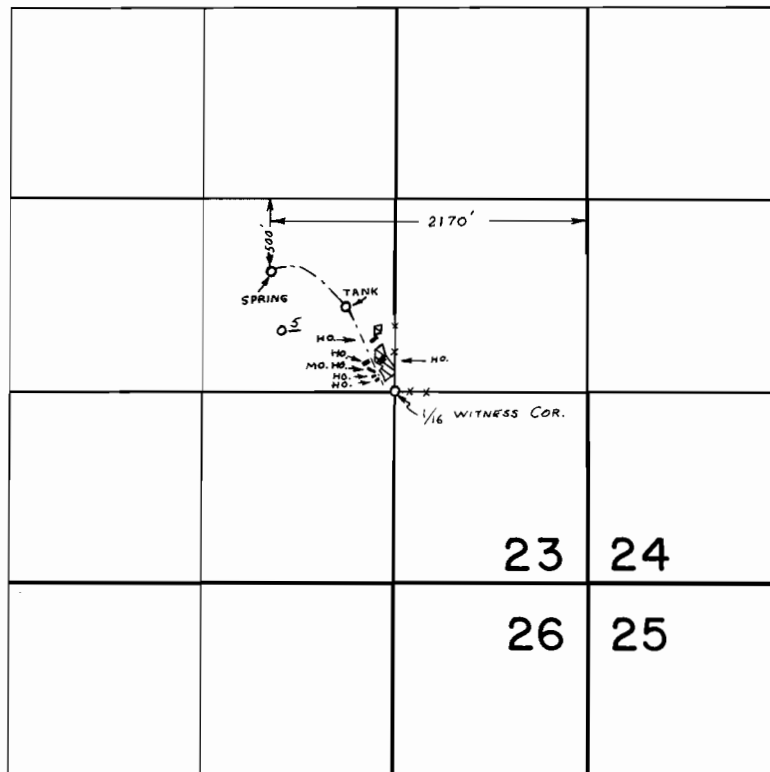

FINAL PROOF SURVEY
UNDER

Application No. 50437 Permit No. 36798
IN NAME OF

CLIFFORD W. TRACY

Surveyed SEPT. 14 1978, by B. SUND