


T. 38 S., R. 4 W., W.M.

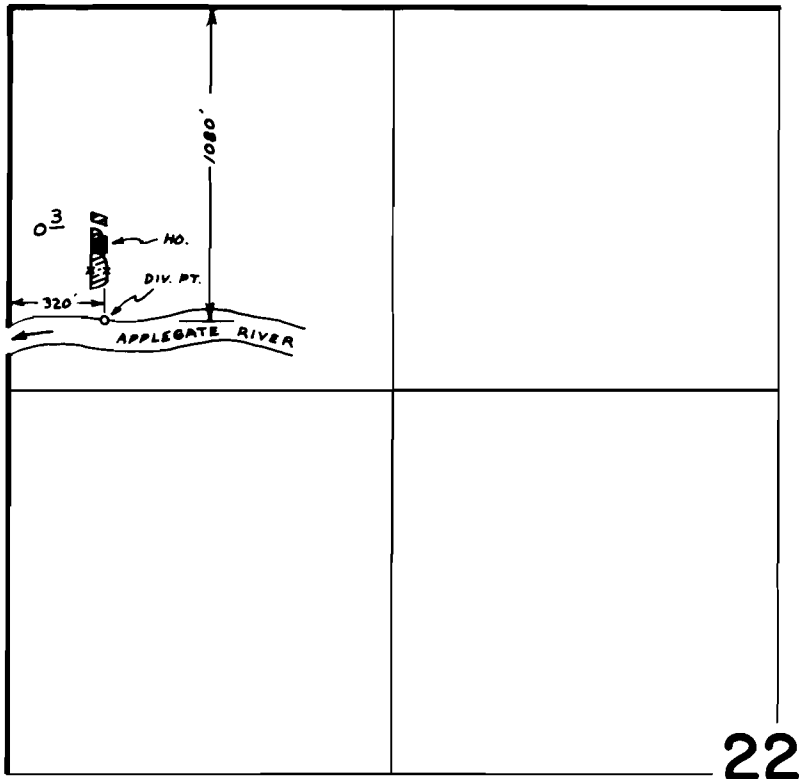

SCALE: 1" = 660 FT.

**FINAL PROOF SURVEY**  
UNDER

Application No. 49694 Permit No. 37202

IN NAME OF

ROAR S. KJAER

Surveyed JUL. 14 1978, by B. SUND