


# T. 33 S., R. 1 E., W. M.

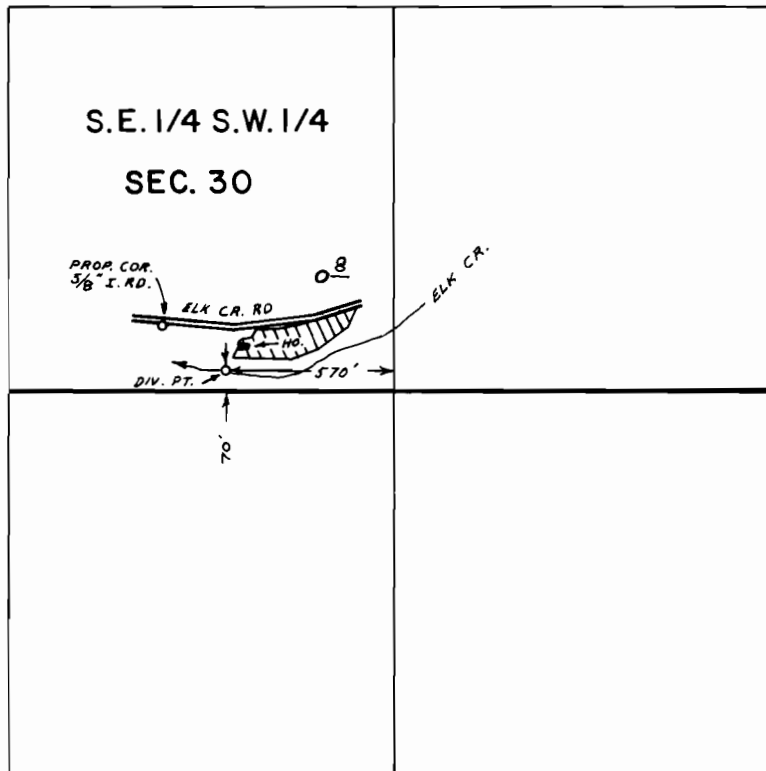

SCALE : 1" = 660 FT.

## FINAL PROOF SURVEY UNDER

Application No. 50132 Permit No. 37667  
IN NAME OF

BRUCE JOHAM

Surveyed AUG. 9 1978, by B. SUND