


T.33 S., R.2 E., W.M.

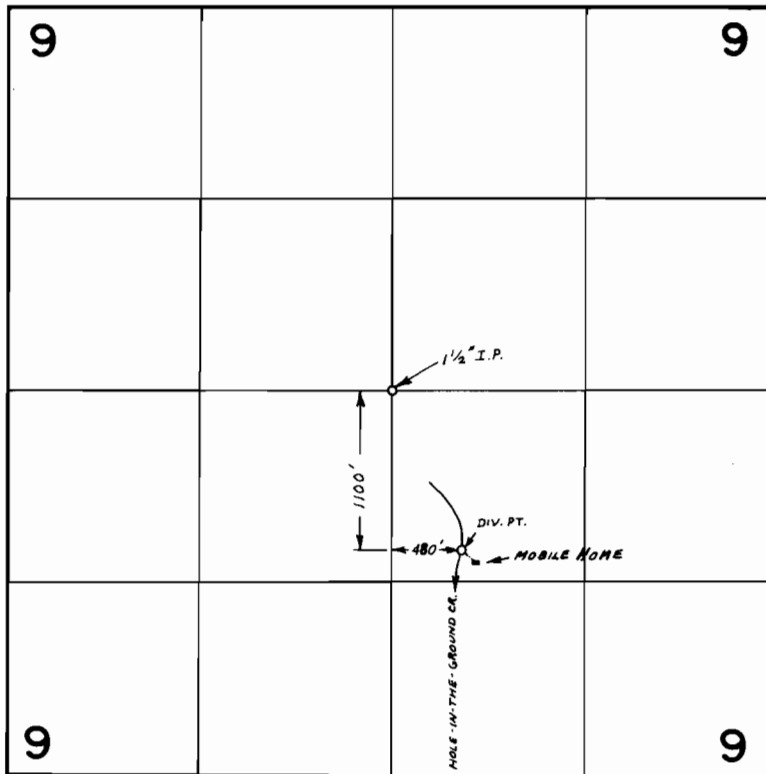

FINAL PROOF SURVEY
UNDER

Application No. 50218 Permit No. 37703
IN NAME OF

ELIZABETH HALE

Surveyed AUG. 28 1978, by B. SUND