


T. 34 S., R. 1 W., W.M.

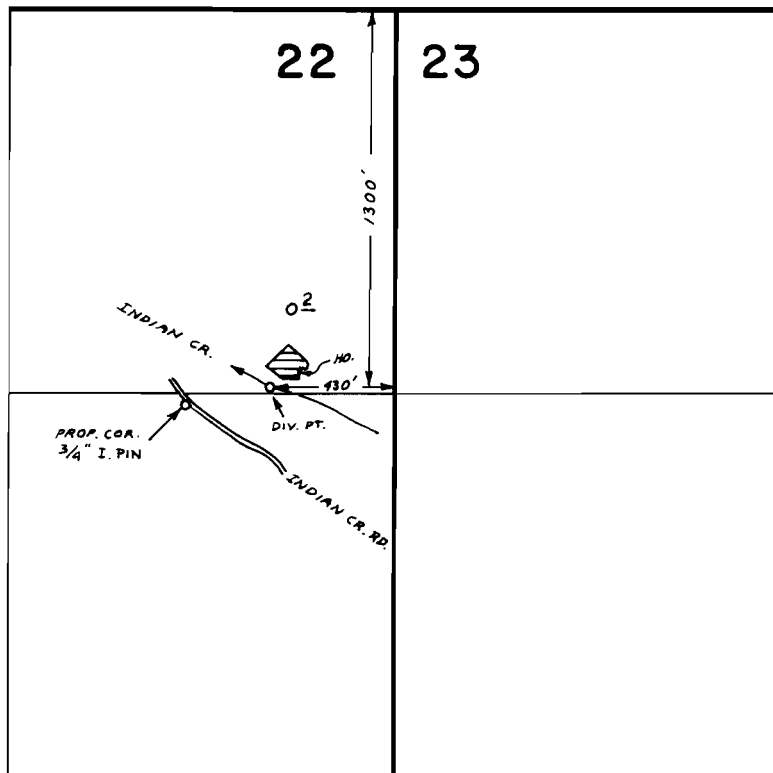

SCALE: 1" = 660 FT.

FINAL PROOF SURVEY UNDER

Application No. 50590 Permit No. 38187
IN NAME OF

ROGER D. ANSEMI

Surveyed OCT. 20 1978, by B. SUND