


T. 35 S., R. 4 W., W.M.

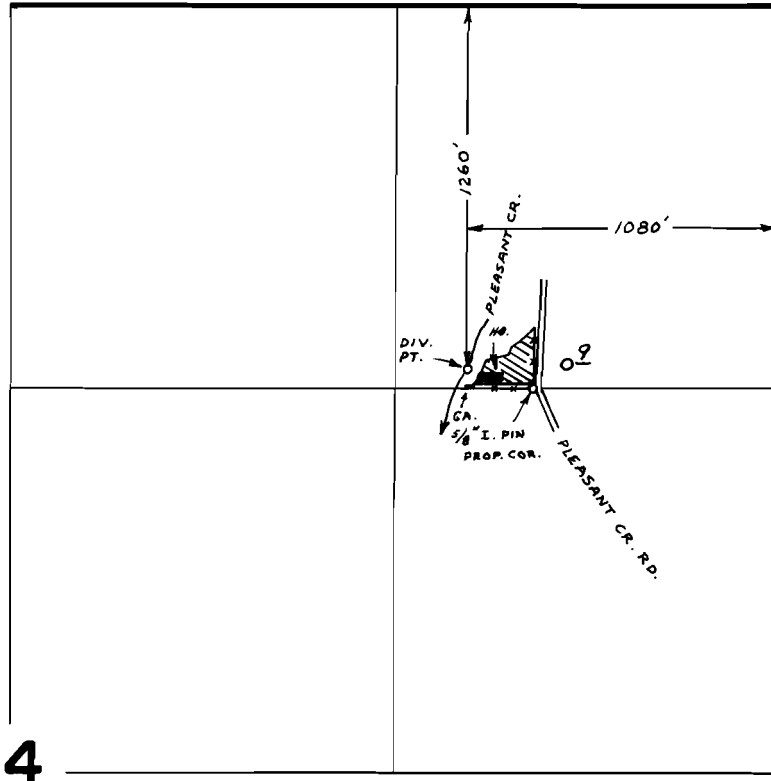

SCALE : 1" = 660 FT.

FINAL PROOF SURVEY UNDER

Application No. 50691 Permit No. 38289
IN NAME OF

KETURA R. RIIS

Surveyed SEPT. 29 1978, by B. SUND