


T. 33 & 34 S., R. 1 W., W.M.

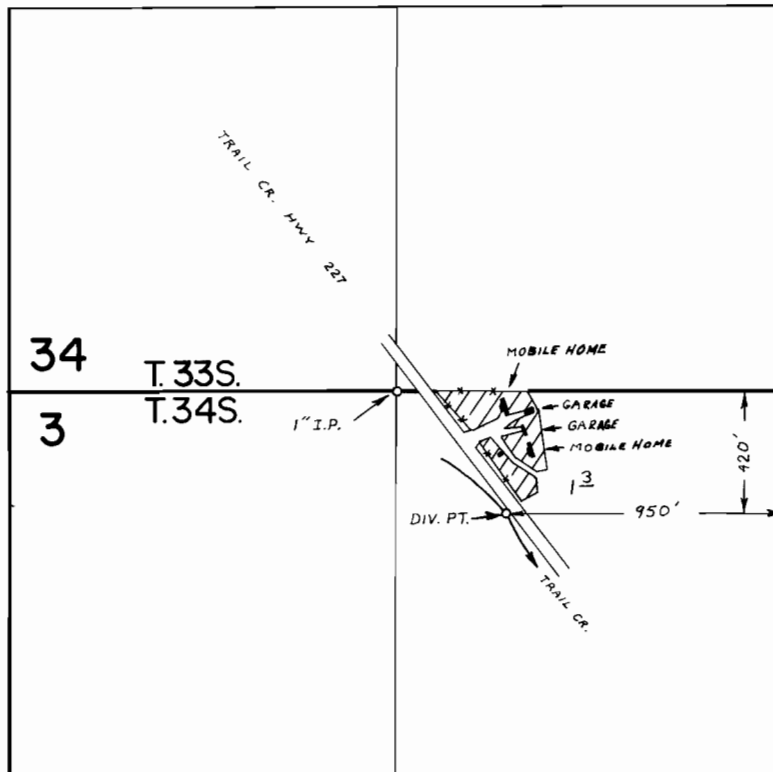

SCALE: 1" = 660 FT.

FINAL PROOF SURVEY UNDER

Application No. 53079 Permit No. 38574
IN NAME OF

D. H. DAVIS

Surveyed AUG. 30 1978, by B. SUND