


T.36 S., R.4 W., W.M.

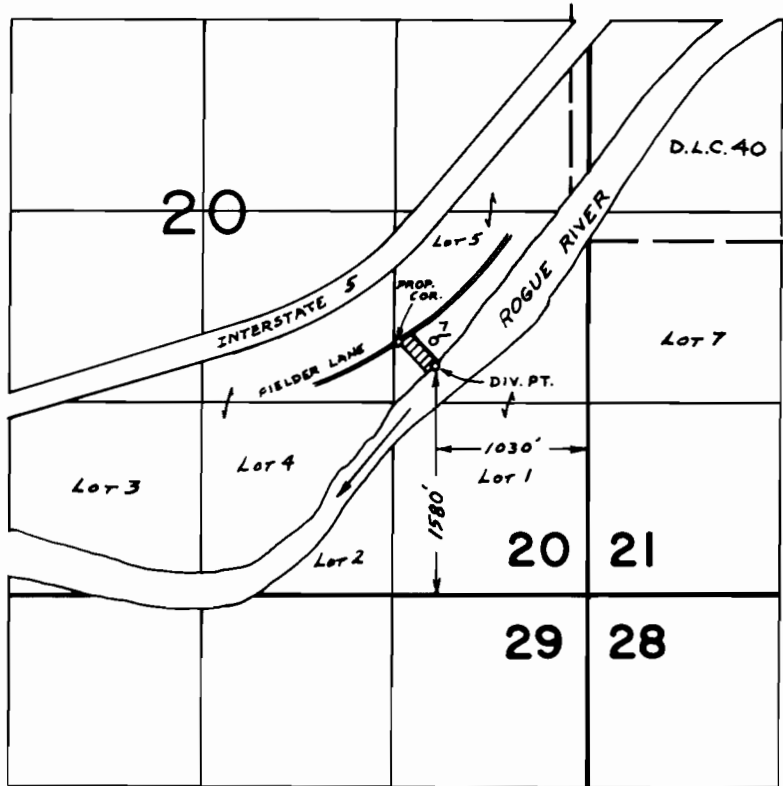

FINAL PROOF SURVEY
UNDER

Application No. 51167 Permit No. 38670
IN NAME OF

LEAH K. POWERS

Surveyed JUL. 20 78, by B. SUND
19.....