


# T. 36 S., R. 4 W., W. M.

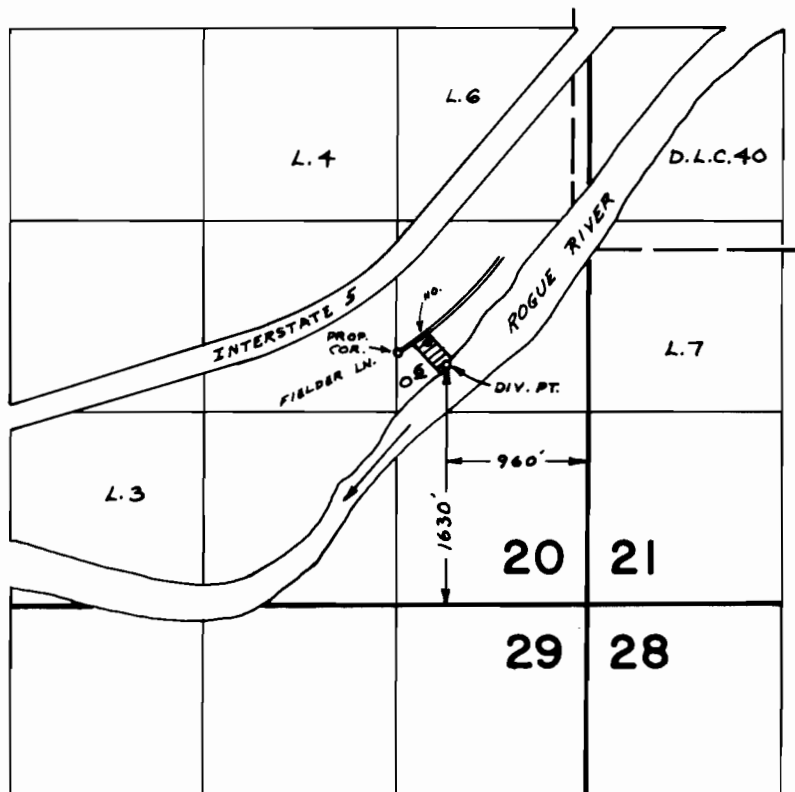

## FINAL PROOF SURVEY UNDER

Application No. 51196 Permit No. 38685  
IN NAME OF

DELMER F. DILTZ

Surveyed JUL. 20 1978, by B. SUND