


T. 36 S., R. 4 W., W.M.

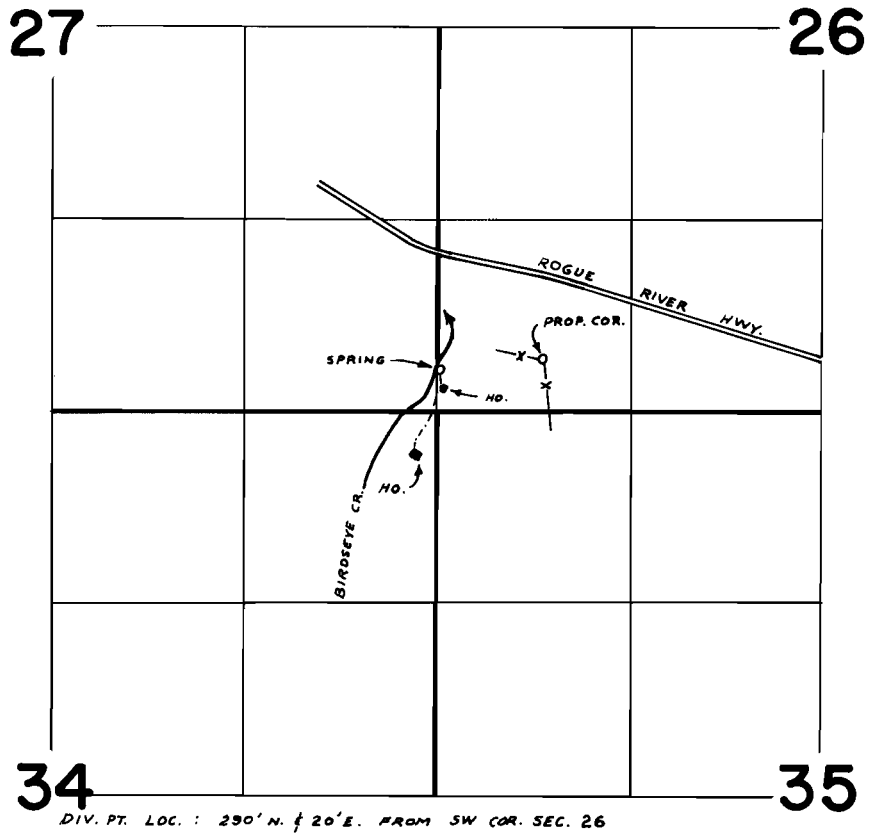

**FINAL PROOF SURVEY**  
UNDER

Application No. 51319 Permit No. 38748  
IN NAME OF  
ROY C. &/OR EMMI M. HINCK  
Surveyed FEB. 23 1978, by B. SUND