


T.33 S., R.2 E., W.M.

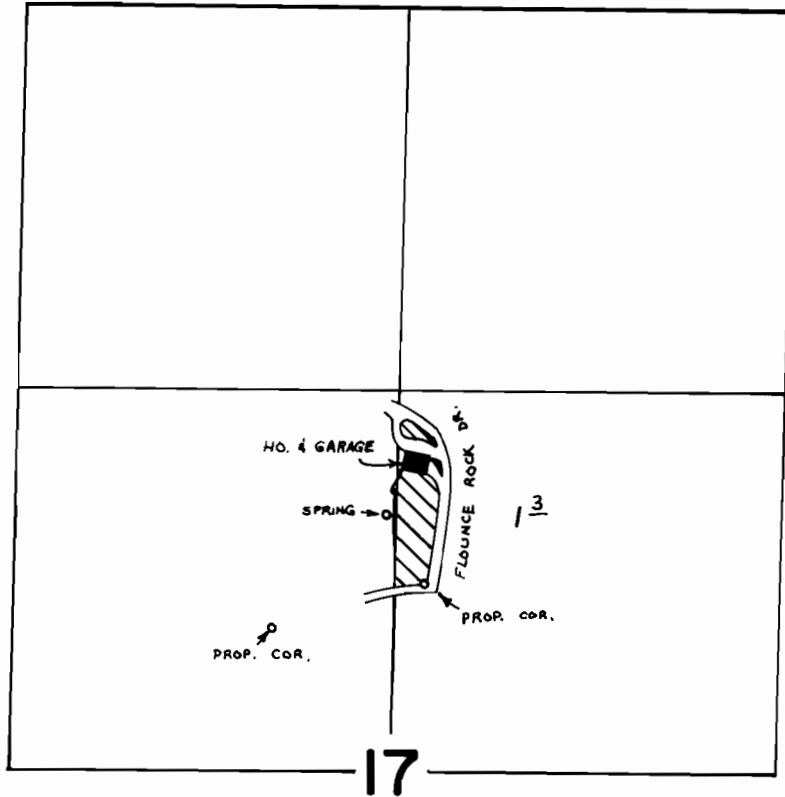

SPRING LOC. - 880' N. & 30' W. FROM CENTER OF SEC. 17.

SCALE: 1" = 660 FT.

FINAL PROOF SURVEY
UNDER

Application No. 52736 Permit No. 39834

IN NAME OF

VINSON H. VAUGHAN

Surveyed AUG. 18 1978, by B. SUND

D.H.M.
P.T.S. - 1978-14-C