


T. 36 S., R. 4 W., W. M.

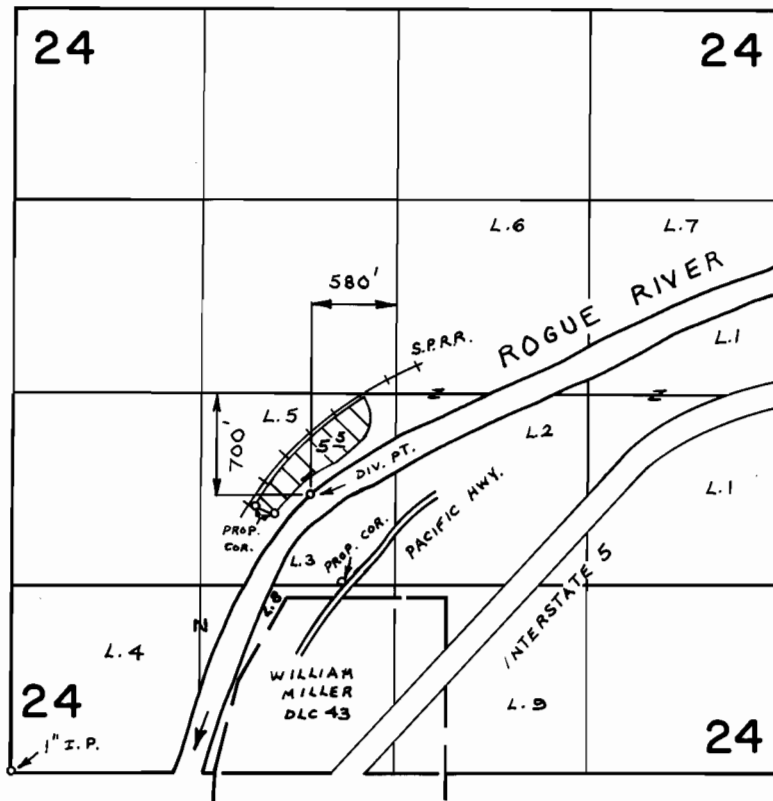

**FINAL PROOF SURVEY  
UNDER**

Application No. 54168 Permit No. 40552  
IN NAME OF

CAROLYN K. MAURER

Surveyed FEB. 22 1978, by B. SUND

D. H. M.  
B50-10-5