


T.38S. R.4W. W.M.

Application No. 56274
Permit No. 42369

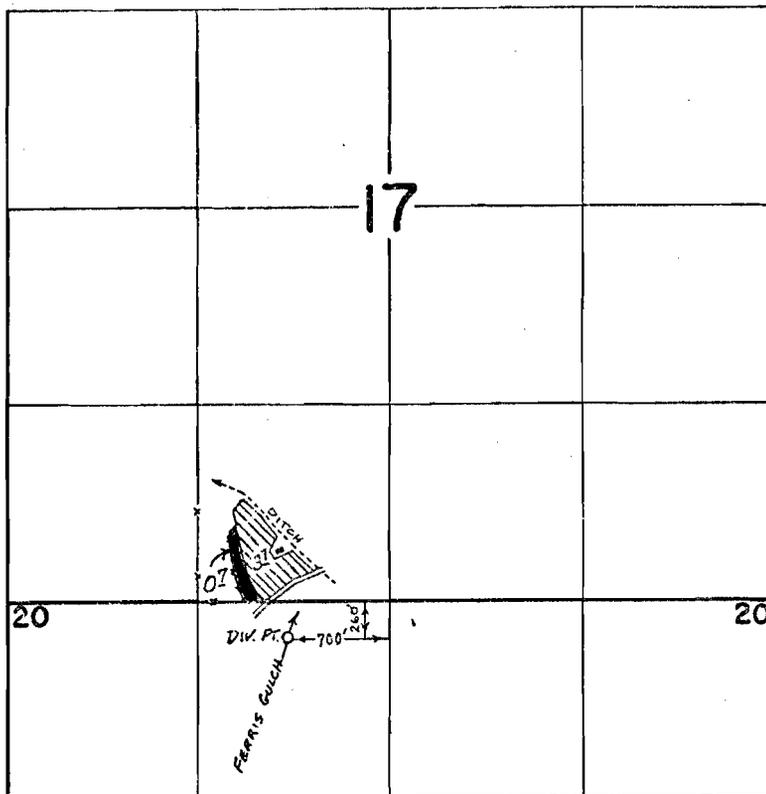

SUPPLEMENTAL IRRIGATION

FINAL PROOF SURVEY
UNDER

Application No. 49080. Permit No. 36817.
IN NAME OF

ROBERT E. BAIZE

Surveyed AUG. 6. 1975. by L. TOLL

