



T.38 S., R.4 W., W.M.

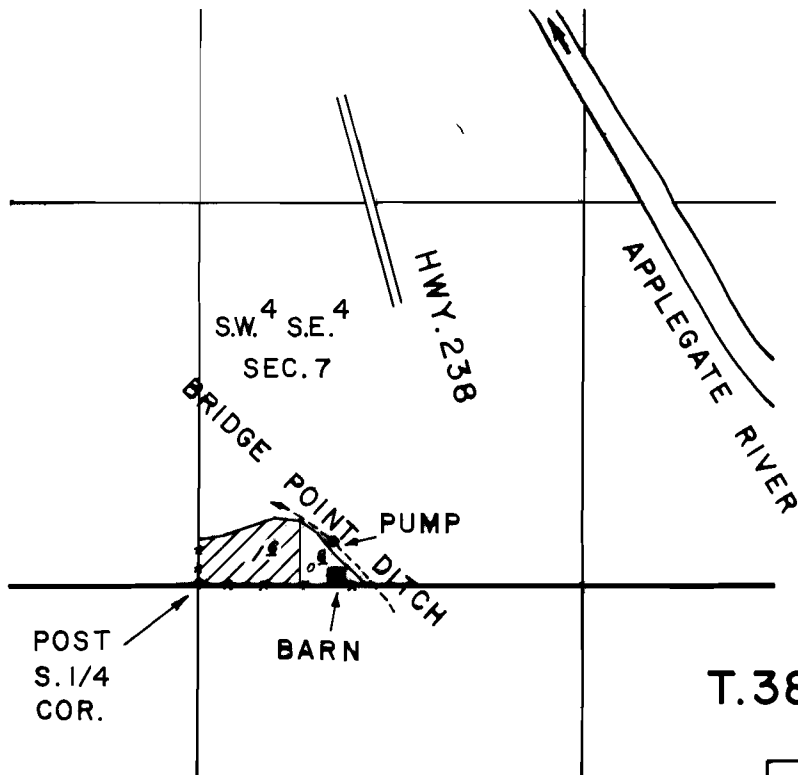

SCALE: 1" = 660 FT.

T.38 S., R.4 W., W.M.

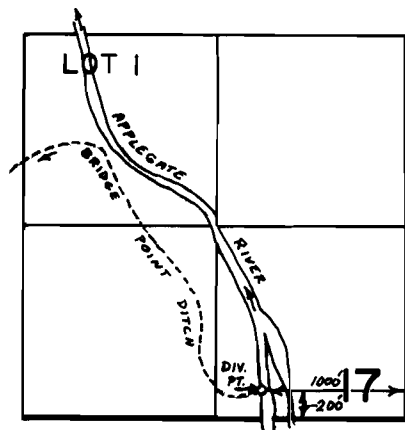

Scale : 4" = 1 mile.

FINAL PROOF SURVEY
UNDER

Application No. 56526 Permit No. 42428
IN NAME OF

MRS. FLOSSIE CARL and/or VERA CARL

Surveyed OCT. 12 1978, by B. SUND

D.H.M.
P.T.S.-1978-14-D
& BAX-4AA-166