


# T.37S., R.6 W., W.M.

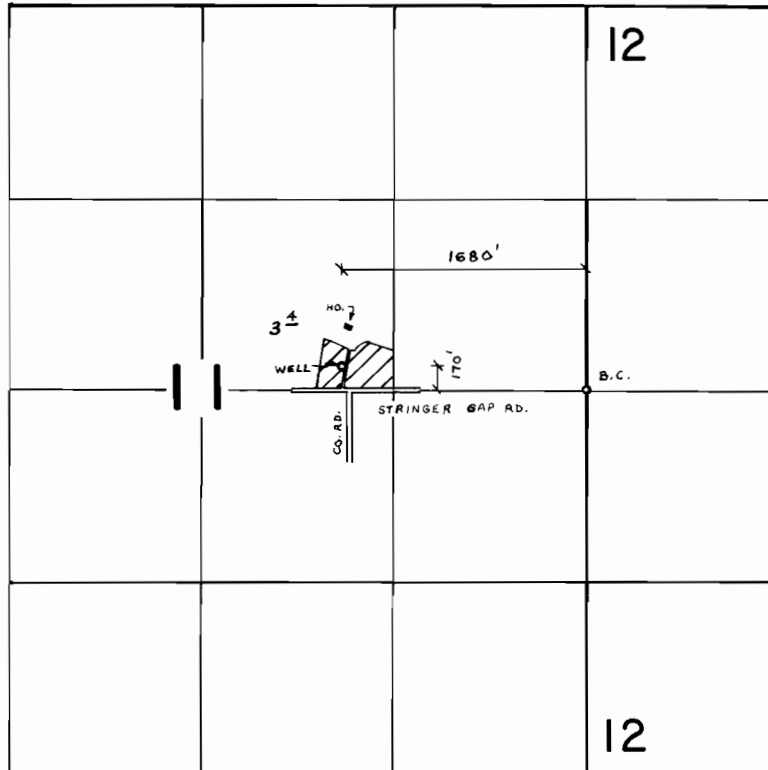

## FINAL PROOF SURVEY UNDER

Application No. G-3851 Permit No. G-3627  
IN NAME OF

GEORGE L. HICKMAN

Surveyed NOV. 9 1978, by B. SUND

D.H.M.

B50-2-4