


# T.34 & 35 S., R.6 W., W.M.

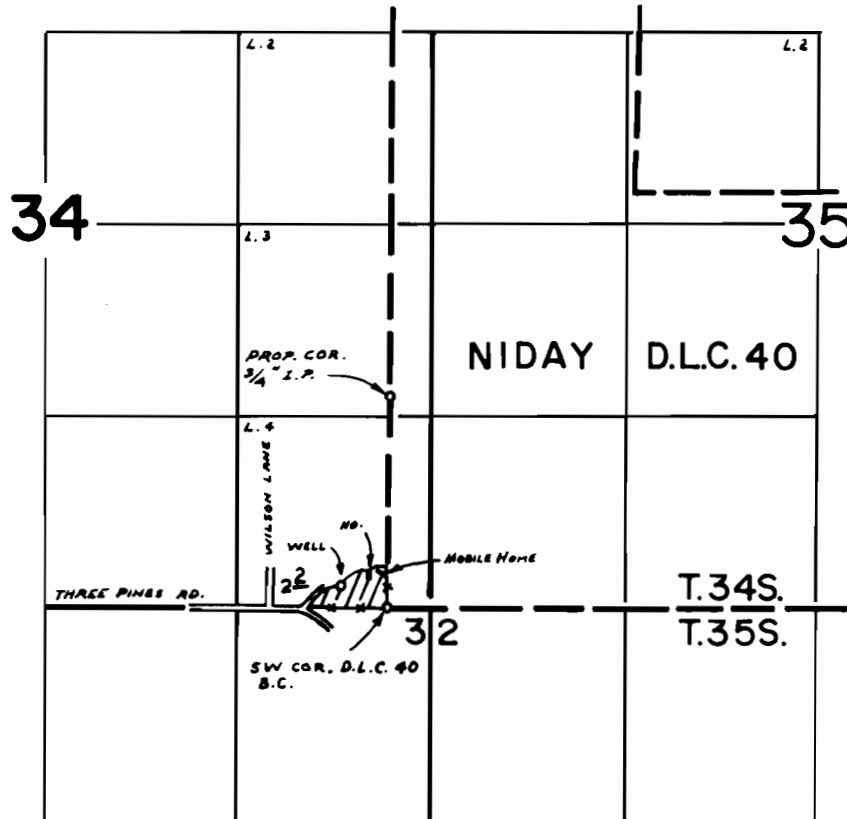

WELL LOC.: 150' N. & 320' W. FROM SE COR. LOT 4 (SE<sup>1</sup>/<sub>4</sub> SE<sup>1</sup>/<sub>4</sub>) SEC. 34

## FINAL PROOF SURVEY UNDER

Application No. G-5864 Permit No. G-5597  
IN NAME OF

EDWARD A. IVORY

Surveyed JUN. 26 1978, by B. SUND