


T.34 S., R.6 W., W.M.

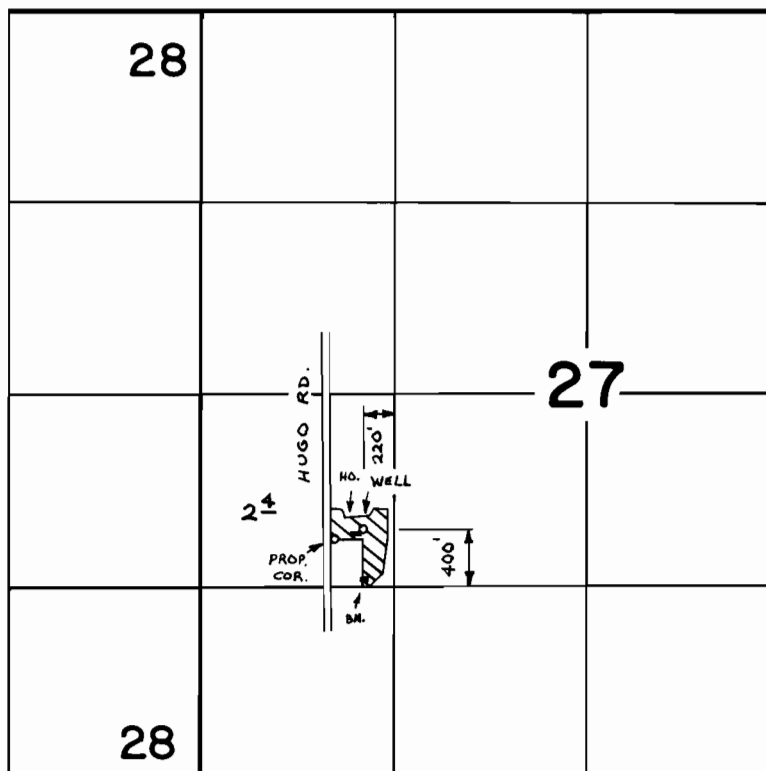

FINAL PROOF SURVEY
UNDER

Application No. G-7201 Permit No. G-6735
IN NAME OF

EDNA J. SUTTON

Surveyed JUN. 26 1978, by B. SUND

D.H.M.

P.T.S.-1978-14-A